

STATE ENGINEER
Salem, Oregon

MARI...191

Well Record

Jackson Co


STATE WELL NO. 3/2W-29M
COUNTY Yamhill
APPLICATION NO. GR-63

OWNER: City of Newberg MAILING ADDRESS:

LOCATION OF WELL: Owner's No. #1 CITY AND STATE: Newberg, Oregon

NE 1/4 SW 1/4 Sec. 29 T. 3 N. S. R. 2 E. W., W.M.

Bearing and distance from section or subdivision corner 1300' E. and 502' S. of the quarter corner between Sec. 29 and Sec. 30

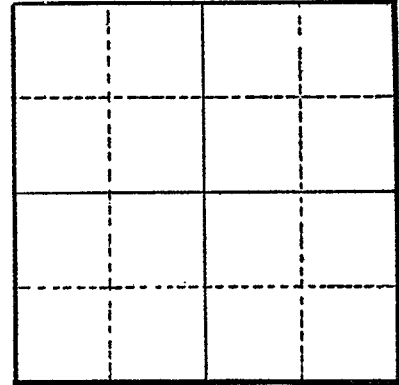

Section 29

Altitude at well 100'

TYPE OF WELL: Drilled Date Constructed

Depth drilled 90' Depth cased 90'

CASING RECORD:

12" casing 0 to 90'

FINISH:

6' perforated casing, location of perforations unknown

AQUIFERS:

Large gravel, (much water) 77 to 88'

WATER LEVEL:

35'

PUMPING EQUIPMENT: Type Byron Jackson 8" submersible H.P. 40 Elec.
Capacity G.P.M.

WELL TESTS:

Drawdown No ft. after 1500 hours G.P.M.
Drawdown ft. after hours G.P.M.

USE OF WATER Municipal Temp. °F., 19

SOURCE OF INFORMATION Weller Probasco / City of Newberg

DRILLER or DIGGER

ADDITIONAL DATA:

Log Water Level Measurements Chemical Analysis Aquifer Test

REMARKS:

