

STATE ENGINEER
Salem, Oregon

Well Record

STATE WELL NO. 5/1W-20F(1)
COUNTY Marion
APPLICATION NO. GR-82

MARI... 1914

OWNER: A. Louis Steffen

MAILING ADDRESS:


LOCATION OF WELL: Owner's No. 1

CITY AND STATE:

Woodburn, Oregon

SE 1/4 NW 1/4 Sec. 20 T. 5 N. S., R. 1 W., W.M.

Bearing and distance from section or subdivision corner N. 87° 30' W. from E 1/4 cor. Sec. 20 48.70 chains

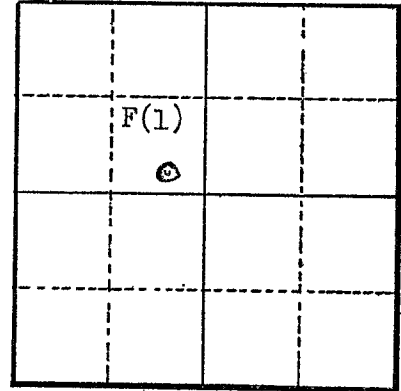

Section 20

Altitude at well 165

TYPE OF WELL: Drilled Date Constructed 7/10/50

Depth drilled 114 Depth cased 114

CASING RECORD:

8 inch casing set from 0 to 114 feet

FINISH:

Slots 1 1/4 x 1/4" 5 rows between 95 and 114 feet

AQUIFERS:

Unknown

WATER LEVEL:

Not available

PUMPING EQUIPMENT: Type Peerless Deepwell turbine H.P. 17
Capacity 200 G.P.M.

WELL TESTS:

Drawdown ft. after hours 200 G.P.M.

Drawdown ft. after hours G.P.M.

USE OF WATER Irrigation 39.5 acres Temp. °F. 19

SOURCE OF INFORMATION Registration Statement GR-82

DRILLER or DIGGER Max Wymore Rt. 2, Box 323B, Salem, Oregon

ADDITIONAL DATA:

Log Water Level Measurements Chemical Analysis Aquifer Test

REMARKS: