

STATE ENGINEER
Salem, Oregon

MARI... 1940

Well Record


STATE WELL NO. 5/1W-22C(1)
COUNTY Marion
APPLICATION NO. G-1502

OWNER: Alfred Aicher MAILING ADDRESS: Route 2, Box 129

LOCATION OF WELL: Owner's No. CITY AND STATE: Woodburn, Oregon

NE 1/4 NW 1/4 Sec. 22 T. 5 N. S, R. 1 E. W., W.M.

Bearing and distance from section or subdivision corner 4593' N. & 1419' E. from SW cor. Sec. 22

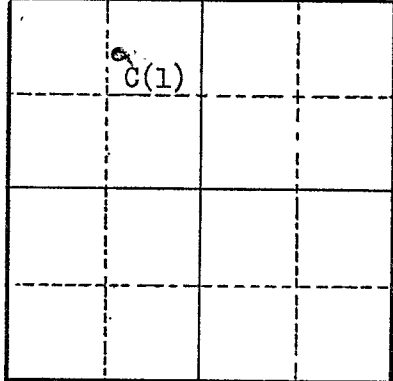

Section 22

Altitude at well

TYPE OF WELL: Drilled Date Constructed 1951

Depth drilled 140 Depth cased 140

CASING RECORD:

8 inch

FINISH:

AQUIFERS:

WATER LEVEL:

PUMPING EQUIPMENT: Type H.P.
Capacity G.P.M.

WELL TESTS:
Drawdown ft. after hours G.P.M.
Drawdown ft. after hours G.P.M.

USE OF WATER Irrigation Temp. °F. 19

SOURCE OF INFORMATION G-1502

DRILLER or DIGGER Orville Wymore

ADDITIONAL DATA:
Log Water Level Measurements Chemical Analysis Aquifer Test

REMARKS: