

STATE ENGINEER
Salem, Oregon

MARI... 1951

Well Record


STATE WELL NO. 5/1W-22F(1)
COUNTY Marion
APPLICATION NO. GR-1

OWNER: John H. Bigler MAILING ADDRESS: Route 2

LOCATION OF WELL: Owner's No. CITY AND STATE: Woodburn, Oregon

SE $\frac{1}{4}$ NW $\frac{1}{4}$ Sec. 22 T. 5 N. S., R. 1 E. W., W.M.

Bearing and distance from section or subdivision corner 325' S. & 860' E. from NE cor. of G.G. Townsend DLC

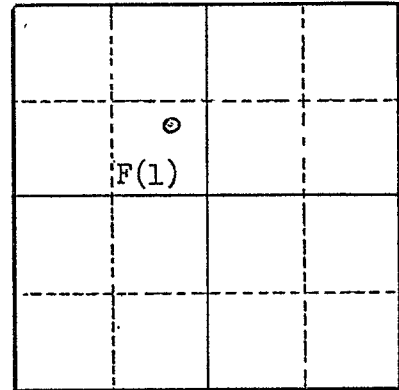

Section 22

Altitude at well 155' Interpolated

TYPE OF WELL: Drilled Date Constructed July '50

Depth drilled 40' Depth cased 40'

CASING RECORD:

6 inch casing set from 0 to 40 feet

FINISH:

$\frac{1}{4}$ inch by 5 inch perforations used from 35 to 40 feet, with 6 perf/foot

AQUIFERS:

Gravel and sand

WATER LEVEL:

Flowing well

PUMPING EQUIPMENT: Type Pacific (centrifugal) H.P. 3
Capacity 100 G.P.M.

WELL TESTS:

Drawdown 18 ft. after _____ hours _____ G.P.M.
Drawdown _____ ft. after _____ hours _____ G.P.M.

USE OF WATER Irrigation Temp. _____ °F. _____, 19____

SOURCE OF INFORMATION Registration Statement GR-1

DRILLER or DIGGER _____

ADDITIONAL DATA:

Log x Water Level Measurements _____ Chemical Analysis _____ Aquifer Test _____

REMARKS:

