

STATE ENGINEER  
Salem, Oregon

MAR 1952 Well Record

STATE WELL NO. 5/1W-22E(2)  
COUNTY Marion  
APPLICATION NO. GR-1013

GR-1036

OWNER: Charles P. Wyffels


MAILING ADDRESS: Rt. 2, Box 127

LOCATION OF WELL: Owner's No. #1

CITY AND STATE: Woodburn, Oregon

SE 1/4 NW 1/4 Sec. 22 T. 5 S. R. 1 W., W.M.

Bearing and distance from section or subdivision corner 2110 ft. E. & 2030 ft. S. from NW cor. of Sec. 22.

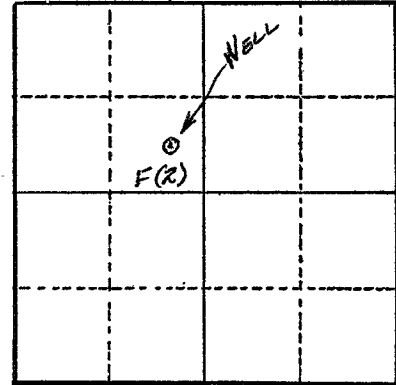

Section 22

Altitude at well 60 ft.

TYPE OF WELL: Drilled Date Constructed 1948

Depth drilled 60 ft. Depth cased 55 ft.

CASING RECORD:

6 inch

FINISH:

1/4" x 6" perforations at the 24 ft. & 45 ft. levels.

AQUIFERS:

WATER LEVEL:

50 ft.

PUMPING EQUIPMENT: Type Jacuzzi turbine H.P. 5

Capacity 70 G.P.M.

WELL TESTS:

Drawdown 30 ft. after 70 hours G.P.M.

Drawdown 45 ft. after 100 hours G.P.M.

USE OF WATER Irrigation Temp. °F. 19

SOURCE OF INFORMATION G.R. Record

DRILLER or DIGGER John Beck - 47

ADDITIONAL DATA:

Log Water Level Measurements Chemical Analysis Aquifer Test

REMARKS:

Log: Grey clay 0 to 12 ft.  
Grey sand 12 to 30 ft.  
Blue clay 30 to 40 ft.  
Sand & rock 40 to 55 ft.  
Blue clay 55 to 60 ft.

Irrigation of 20 acres.