

STATE ENGINEER
Salem, Oregon

Well Record

STATE WELL NO. 5/1W-22M(2)
COUNTY Marion
APPLICATION NO. CR-265

OWNER: Glenn H. Newton

MAILING

ADDRESS: Woodburn,

LOCATION OF WELL: Owner's No. #1


CITY AND

STATE: Oregon

NW 1/4 SW 1/4 Sec. 22 T. 5 N. R. 1 E. W., W.M.

Bearing and distance from section or subdivision

corner 2200' N. & 200' E. of SW cor. Sec. 22

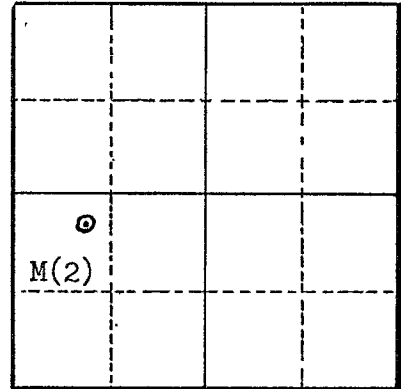

Section 26

Altitude at well 160' Interpolated

TYPE OF WELL: Drilled Date Constructed 8/17/49

Depth drilled 80' Depth cased 80'

CASING RECORD:

6 inch casing set from 0 to 80 feet

FINISH:

Perforated from 60 to 80 feet

AQUIFERS:

Sand 0 to 80 feet?

WATER LEVEL:

30 feet below land surface

PUMPING EQUIPMENT: Type Turbine H.P. 5
Capacity 50 G.P.M.

WELL TESTS:

Drawdown 10 ft. after pumping 50 hours G.P.M.

Drawdown ft. after hours G.P.M.

USE OF WATER Irrigation 25 acres Temp. °F., 19

SOURCE OF INFORMATION Registration Statement CR-265

DRILLER or DIGGER Vernon Coleman Woodburn, Oregon

ADDITIONAL DATA:

Log ☒ Water Level Measurements Chemical Analysis Aquifer Test

REMARKS:

Sand 0 to 80 feet