

STATE ENGINEER  
Salem, Oregon

1956  
MARION.....

# Well Record


STATE WELL NO. 5/1W-22P(1)  
COUNTY Marion  
APPLICATION NO. GR-9

OWNER: Clifford E. & Blanche Norton MAILING ADDRESS: Route 2

LOCATION OF WELL: Owner's No. CITY AND STATE: Woodburn, Oregon

SE 1/4 SW 1/4 Sec. 22 T. 5 S., R. 1 W., W.M.

Bearing and distance from section or subdivision corner 3281' N. & 280' W. of center of Sec. 27

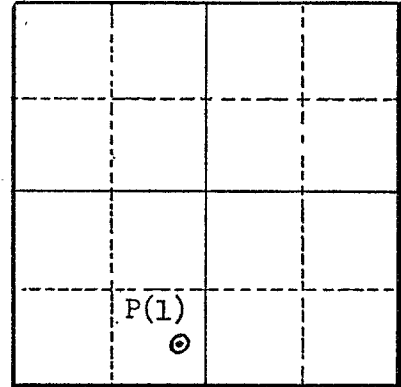

Section 22

Altitude at well 170' Interpolated

TYPE OF WELL: Drilled Date Constructed 1942

Depth drilled 79 1/2 Depth cased 79

### CASING RECORD:

5 inch casing set from 0 to 79 feet

### FINISH:

None

### AQUIFERS:

### WATER LEVEL:

18 feet below land surface September 1955

PUMPING EQUIPMENT: Type Peerless Turbine 2 1/2 H.P. 3  
Capacity 80 G.P.M.

### WELL TESTS:

Drawdown 20 ft. after hours 75 G.P.M.  
Drawdown ft. after hours G.P.M.

USE OF WATER Irrigation 20 acres Temp. °F., 19

SOURCE OF INFORMATION Registration Statement GR-9

DRILLER or DIGGER Bryon Ballweber Route 2, Woodburn, Oregon

### ADDITIONAL DATA:

Log No Water Level Measurements x Chemical Analysis Aquifer Test

### REMARKS: