

STATE ENGINEER
Salem, Oregon

MAR 1993

Well Record

STATE WELL NO. 5/1W-26G(1)
COUNTY Marion
APPLICATION NO. GR- 1109

GR- 1069

OWNER: Virgil N. Ryan

MAILING ADDRESS: Rt. 2


LOCATION OF WELL: Owner's No. _____

CITY AND STATE: Woodburn, Oregon

SW 1/4 NE 1/4 Sec. 26 T. 5 S., R. 1 W., W.M.

Bearing and distance from section or subdivision

corner 334' N. & 690' E. of the Center of Sec. 26.

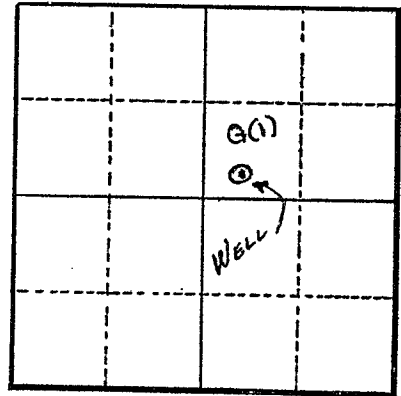

Section 26

Altitude at well 195 ft.

TYPE OF WELL: Drilled Date Constructed 1951

Depth drilled 114 ft. Depth cased 114 ft.

CASING RECORD:

6 inch

FINISH:

- 1 row of Mills perforations from 70 to 85 ft.
- 2 rows of Mills perforations from 85 to 110 ft.

AQUIFERS:

WATER LEVEL:

45 ft.

PUMPING EQUIPMENT: Type Peerless Lineshaft turbine H.P. 5
Capacity 85 G.P.M.

WELL TESTS:

Drawdown 22 ft. after _____ hours 180 G.P.M.

Drawdown _____ ft. after _____ hours _____ G.P.M.

USE OF WATER Irrigation Temp. _____ °F. _____, 19____

SOURCE OF INFORMATION G. R. Record

DRILLER or DIGGER _____

ADDITIONAL DATA:

Log _____ Water Level Measurements _____ Chemical Analysis _____ Aquifer Test _____

REMARKS:

Log: Unknown 0 to 5 ft.
Brown gravel 5 to 25 ft.
Blue gravel 25 to 110 ft.

Irrigation of 10 acres.