

STATE ENGINEER  
Salem, Oregon

M 172003

# Well Record

STATE WELL NO. 5/1W-260  
COUNTY Marion  
APPLICATION NO. GR-2281

OWNER: Annen Bros.


MAILING ADDRESS: Rt. 1, Box 92

LOCATION OF WELL: Owner's No.

CITY AND STATE: Mt. Angel, Oregon

SW 1/4 SE 1/4 Sec. 26 T. 5 N. S., R. 1 E. W., W.M.

Bearing and distance from section or subdivision corner 5 chains N. & 31 chains W. from the SE corner Sec. 26

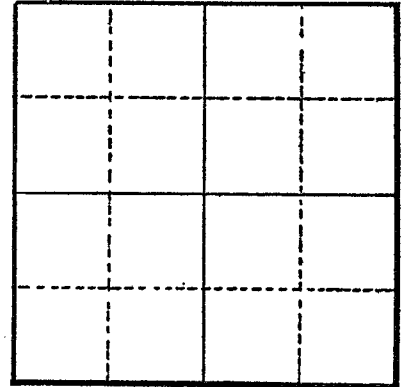

Section 26

Altitude at well

TYPE OF WELL: Drilled Date Constructed 1953

Depth drilled 188 Depth cased 188

### CASING RECORD:

10 inch from 0 to 188 feet

### FINISH:

3/8 x 1 1/2 slots 1 row 45 to 55' 3 row 110 to 115'  
4 " 65 to 85' 3 " 155 to 185'

### AQUIFERS:

### WATER LEVEL:

58 feet

PUMPING EQUIPMENT: Type \_\_\_\_\_ H.P. 30  
Capacity 400 G.P.M.

### WELL TESTS:

Drawdown \_\_\_\_\_ ft. after \_\_\_\_\_ hours \_\_\_\_\_ G.P.M.  
Drawdown \_\_\_\_\_ ft. after \_\_\_\_\_ hours \_\_\_\_\_ G.P.M.

USE OF WATER Irrigation Temp. \_\_\_\_\_ °F. \_\_\_\_\_, 19

SOURCE OF INFORMATION GR-2281

DRILLER or DIGGER J. W. Beck

### ADDITIONAL DATA:

Log \_\_\_\_\_ Water Level Measurements \_\_\_\_\_ Chemical Analysis \_\_\_\_\_ Aquifer Test \_\_\_\_\_

### REMARKS:

