

STATE ENGINEER
Salem, Oregon

MARI. 2026 Well Record


STATE WELL NO. 5/1W-27A
COUNTY Marion
APPLICATION NO. CR-855

OWNER: Paul Simon MAILING ADDRESS: Route 2, Box 57

LOCATION OF WELL: Owner's No. #1 CITY AND STATE: Woodburn, Oregon

NE 1/4 NE 1/4 Sec. 27 T. 5 N. S. R. 1 E. W., W.M.

Bearing and distance from section or subdivision corner 10 chains W. & 95 chains S. from NE cor. Sec. 27

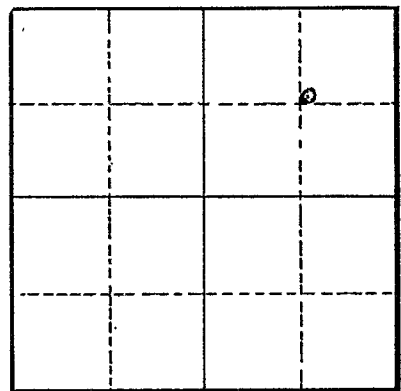

Section 27

Altitude at well 180

TYPE OF WELL: Drilled Date Constructed Aug. '39

Depth drilled 110 Depth cased

CASING RECORD:

8" steel 0 to 110

FINISH:

Perf. 4' of 5/8" holes 40 holes per foot 106-110'

AQUIFERS:

WATER LEVEL:

30

PUMPING EQUIPMENT: Type Pomona turbine H.P. 5 Elec.
Capacity 120 G.P.M.

WELL TESTS:

Drawdown ft. after hours G.P.M.
Drawdown ft. after hours G.P.M.

USE OF WATER Irrigation Temp. °F. 19

SOURCE OF INFORMATION Owner
DRILLER or DIGGER B. F. Ballweber Rt. 2, Box 73, Woodburn

ADDITIONAL DATA:

Log NA Water Level Measurements Chemical Analysis Aquifer Test

REMARKS: