

STATE ENGINEER
Salem, Oregon

MAR 20 1930

Well Record

STATE WELL NO. 5/1W-27M
COUNTY Marion
APPLICATION NO. GR-3665


OWNER: Ralph S. Tenger
MAILING ADDRESS: Route 2

LOCATION OF WELL: Owner's No.
CITY AND STATE: Woodburn, Oregon

NW 1/4 SW 1/4 Sec. 27 T. 5 N. S. R. 1 W., W.M.

Bearing and distance from section or subdivision

corner 1000 yds. of McKee School

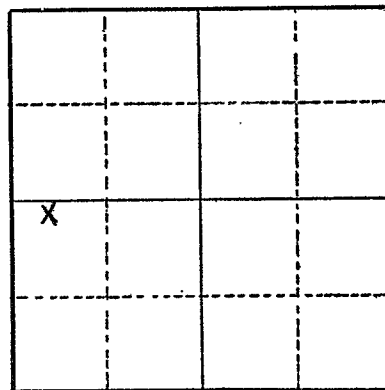

Altitude at well

TYPE OF WELL: Drilled Date Constructed Oct. 1952

Depth drilled 265 feet Depth cased 265 feet

Section 27

CASING RECORD:

6 inch steel casing set to 265 feet

FINISH:

AQUIFERS:

WATER LEVEL:

35 feet below surface

PUMPING EQUIPMENT: Type Jacuzzi deep well turbine H.P. 10
Capacity 120 G.P.M.

WELL TESTS:

Drawdown 245 ft. after 550 hours G.P.M.

Drawdown ft. after hours G.P.M.

USE OF WATER Irrigation Temp. °F. 19

SOURCE OF INFORMATION Well Registration Statement

DRILLER or DIGGER

ADDITIONAL DATA:

Log Water Level Measurements Chemical Analysis Aquifer Test

REMARKS: