

STATE ENGINEER  
Salem, Oregon

MARI. 2054

# Well Record

STATE WELL NO. 5/1W-28H  
COUNTY Marion  
APPLICATION NO. GR-1569

OWNER: C. A. J. Vandecoeveering


GR- 1511  
MAILING ADDRESS: Rt. 2, Box 44

LOCATION OF WELL: Owner's No. \_\_\_\_\_

CITY AND STATE: Woodburn, Oregon

XX XX  
SE 1/4 NE 1/4 Sec. 28 T. 5 S., R. 1 W., W.M.

Bearing and distance from section or subdivision  
corner 1400' S. & 900' W. from NE cor. Sec. 28

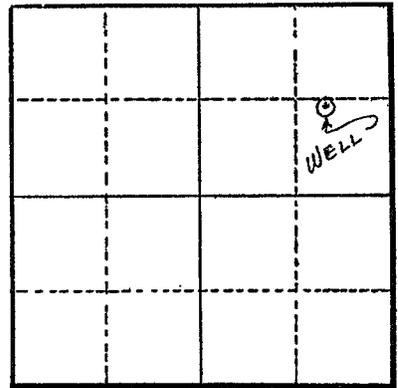

Section 28

Altitude at well \_\_\_\_\_

TYPE OF WELL: Drilled Date Constructed 1948

Depth drilled 131' Depth cased 131'

### CASING RECORD:

8"

### FINISH:

Slot perforated: 15/ft., size 1 1/2" x 1/4" from 80 to 85 ft. & from 118 to 128 ft.

### AQUIFERS:

Sand & gravel

### WATER LEVEL:

12'

PUMPING EQUIPMENT: Type Turbine

H.P. 7 1/2

Capacity 210 G.P.M.

### WELL TESTS:

Drawdown 30 ft. after \_\_\_\_\_ hours 400 G.P.M.

Drawdown 50 ft. after \_\_\_\_\_ hours 600 G.P.M.

USE OF WATER Irrigation Temp. \_\_\_\_\_ °F., 19

SOURCE OF INFORMATION GR Record

DRILLER or DIGGER \_\_\_\_\_

### ADDITIONAL DATA:

Log \_\_\_\_\_ Water Level Measurements \_\_\_\_\_ Chemical Analysis \_\_\_\_\_ Aquifer Test \_\_\_\_\_

### REMARKS:

Log: Clay 0 to 80 ft.  
Gravel & sand 80 to 85 ft.  
Sand & gravel 85 to 128 ft.

Irrigation of 39.3 acres.