

STATE ENGINEER
Salem, Oregon

MAR 20 1957

Well Record


STATE WELL NO. 5/1W-28Q(1)
COUNTY Marion
APPLICATION NO. GR-32

OWNER: Lawrence W. Zach MAILING ADDRESS: _____

LOCATION OF WELL: Owner's No. _____ CITY AND STATE: Woodburn, Oregon

SW 1/4 SE 1/4 Sec. 28 T. 5 N. S. R. 1 W., W.M.

Bearing and distance from section or subdivision corner 13.17 chains N. from 1/4 corner Sec. 28 & 33

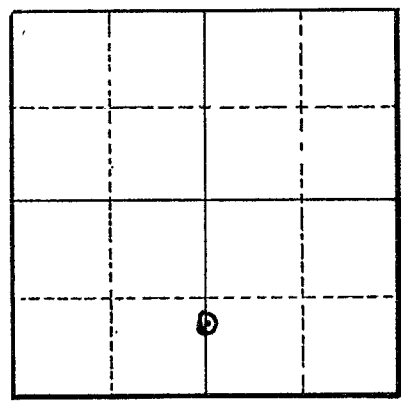

Section 28

Altitude at well 180 feet Interpolated

TYPE OF WELL: Drilled Date Constructed April '55

Depth drilled 177' Depth cased 163'

CASING RECORD:

8 inch casing set from 0 to 163 feet

FINISH:

Perforations set from 64 to 108 feet. Total 180 perforations

AQUIFERS:

Gravel from 64 to 66 and from 72 to 108 feet

WATER LEVEL:

12 feet below land surface April 1955

PUMPING EQUIPMENT: Type Cook turbine H.P. 15
Capacity 200 G.P.M.

WELL TESTS:

Drawdown 55 ft. after _____ hours 240 G.P.M.
Drawdown _____ ft. after _____ hours _____ G.P.M.

USE OF WATER Irrigation 35 acres Temp. 21.0 °F, 19

SOURCE OF INFORMATION Registration Statement GR-32

DRILLER or DIGGER Sneed & Sons 2505 Brooks St., Salem, Oregon

ADDITIONAL DATA:

Log Water Level Measurements _____ Chemical Analysis _____ Aquifer Test _____

REMARKS:

