

NOTICE TO WATER WELL CONTRACTOR  
The original and first copy of this report  
are to be filed with the

WATER RESOURCES DEPARTMENT  
SALEM, OREGON 97310  
within 30 days from the date  
of well completion.

# MARI 2068 WATER WELL REPORT

STATE OF OREGON  
(Please type or print)

(Do not write above this line)

# RECEIVED

MAY 1 1978

State Well No. 53/1W-29cd

State Permit No. \_\_\_\_\_

### (1) OWNER:

Name Knolview Nursery & Farms, Inc.  
Address 10906 Monitor-McKee Rd NE  
Woodburn, Ore. 97071

### (2) TYPE OF WORK (check):

New Well  Deepening  Reconditioning  Abandon   
If abandonment, describe material and procedure in Item 12.

### (3) TYPE OF WELL:

Rotary  Driven   
Cable  Jetted   
Dig  Bored

### (4) PROPOSED USE (check):

Domestic  Industrial  Municipal   
Irrigation  Test Well  Other

### CASING INSTALLED:

Threaded  Welded   
6" Diam. from +2'6" ft. to 228'7" ft. Gage .375  
8" Diam. from +2'5" ft. to 232'7" ft. Gage .250  
\*6" Diam. from +1'9" ft. to 22'6" ft. Gage .250

### PERFORATIONS:

Perforated?  Yes  No.

Type of perforator used Torch & mill cut  
Size of perforations Torch 3/8 by 6 in.  
Mill C 3/8 x 2 1/2  
perforations from \_\_\_\_\_ ft. to \_\_\_\_\_ ft.  
\*\*  
perforations from \_\_\_\_\_ ft. to \_\_\_\_\_ ft.  
perforations from \_\_\_\_\_ ft. to \_\_\_\_\_ ft.

### (7) SCREENS:

Well screen installed?  Yes  No

Manufacturer's Name \_\_\_\_\_  
Type \_\_\_\_\_ Model No. \_\_\_\_\_  
Diam. \_\_\_\_\_ Slot size \_\_\_\_\_ Set from \_\_\_\_\_ ft. to \_\_\_\_\_ ft.  
Diam. \_\_\_\_\_ Slot size \_\_\_\_\_ Set from \_\_\_\_\_ ft. to \_\_\_\_\_ ft.

### (8) WELL TESTS:

Drawdown is amount water level is lowered below static level

Was a pump test made?  Yes  No If yes, by whom? SEI  
Id: \_\_\_\_\_ gal./min. with \_\_\_\_\_ ft. drawdown after \_\_\_\_\_ hrs.  
See sheet Attached " " "  
" " " " "  
Bailer test \_\_\_\_\_ gal./min. with \_\_\_\_\_ ft. drawdown after \_\_\_\_\_ hrs.  
Artesian flow \_\_\_\_\_ g.p.m.  
Temperature of water \_\_\_\_\_ Depth artesian flow encountered \_\_\_\_\_ ft.

### (9) CONSTRUCTION:

Well seal—Material used 69 yds 6 sk readmix  
Well sealed from land surface to 22 ft.  
Diameter of well bore to bottom of seal 32 in.  
Diameter of well bore below seal 32 in.  
Number of sacks of cement used in well seal 414 sacks  
How was cement grout placed? well pumped down below seal & concrete poured from top

Was a drive shoe used?  Yes  No Plugs \_\_\_\_\_ Size: location \_\_\_\_\_ ft.  
Did any strata contain unusable water?  Yes  No  
Type of water? \_\_\_\_\_ depth of strata? \_\_\_\_\_  
Method of sealing strata off? \_\_\_\_\_  
Was well gravel packed?  Yes  No Size of gravel: 3/4-1/2  
Gravel placed from 22 ft. to bottom ft.

### (10) LOCATION OF WELL:

County Marion, Oregon Driller's well number 7807  
SE 1/4 SW 1/4 Section 29 T. 5S R. 1W W.M.  
Bearing and distance from section or subdivision corner \_\_\_\_\_

### (11) WATER LEVEL: Completed well.

Depth at which water was first found \_\_\_\_\_ ft.  
Static level 13 ft. below land surface. Date 4-25-78  
Artesian pressure \_\_\_\_\_ lbs. per square inch. Date \_\_\_\_\_

### (12) WELL LOG:

Diameter of well below casing \_\_\_\_\_  
Depth drilled 363 ft. Depth of completed well 287-18 ft. pt  
pt

Formation: Describe color, texture, grain size and structure of materials; and show thickness and nature of each stratum and aquifer penetrated, with at least one entry for each change of formation. Report each change in position of Static Water Level and indicate principal water-bearing strata.

MATERIAL	From	To	SWL
See sheet attached			
*Gravel Feed			
**Perforations			
Casing Type Size No			
16" Torch 3/8 x6 836	107	167	
16" Mill C3/8x2 1/2 1520	167	207	
8" Torch 3/8 x6 456	152	212	

Work started 2-21 19 78 Completed 4-25 19 78  
Date well drilling machine moved off of well 4-25 19 78

### Drilling Machine Operator's Certification:

This well was constructed under my direct supervision. Materials used and information reported above are true to my best knowledge and belief.

[Signed] Thomas A. Schell Date 4-26, 19 78  
(Drilling Machine Operator)

Drilling Machine Operator's License No. 1121

### Water Well Contractor's Certification:

This well was drilled under my jurisdiction and this report is true to the best of my knowledge and belief.

Name Schneider Equipment, Inc.  
(Person, firm or corporation) (Type or print)

Address 21881 River Rd NE, St. Paul, Ore. 97137

[Signed] Stephen J. Schneider  
(Water Well Contractor)


Contractor's License No. 649 Date 4-26, 19 78

Material	From	To
Topsoil	0	3
Clay, brown silty	3	12
Clay, brown soft	12	23
Clay, brown silty	23	29
Clay, brown w/ layers of med brown sandstone	29	40
Clay, blue gritty	40	45
Sand, brown fine & some med gravel	45	48
Gravel, medium & sand, blue medium	48	50
Clay, blue-green	50	56
Clay, grey	56	59
Sand, brown fine & silt	59	67
Gravel, medium & sand, brown medium	67	79
Gravel, coarse & sand, blue coarse	79	92
Boulders - bit plugged	92	112
Clay, blue	112	114
Sand, blue fine and clay, blue	114	119
Gravel, coarse and sand, blue medium	119	123
Boulders & sand, blue medium	123	127
Gravel, coarse & sand, blue medium	127	137
Gravel, medium & sand, blue medium	137	148
Gravel, coarse & sand, blue medium	148	154
Clay, blue	154	156
Clay, grey	156	158
Sand, grey fine w/ some clay, grey	158	164
Sand, grey medium	164	167
Gravel, coarse & sand, blue medium	167	174
Gravel, medium & fine	174	175
Clay, grey fine sandy	175	181
Gravel, medium & sand, grey fine	181	182
Gravel, coarse & sand, blue medium	182	184
Sand, blue medium	184	188
Sand, grey fine	188	191
Gravel, medium & sand, grey medium	191	194
Sand, grey medium & gravel, fine	194	202
Sand, grey medium & gravel, medium	202	204
Clay, grey	204	221
Clay, green	221	228
Clay, grey	228	231
Clay, blue	231	234
Clay, grey sandy	234	239
Clay, blue hard	239	240
Clay, tan	240	245
Clay, grey	245	251
Clay, blue	251	260
Clay, grey	260	269
Clay, blue	269	279
Clay, grey gritty	279	284
Clay, blue	284	296
Clay, grey	296	311
Clay, blue	311	333
Clay, blue soft	333	345
Clay, grey soft	345	354
Clay, blue-grey soft	354	363

SCHNEIDER EQUIPMENT, INC.  
 21881 RIVER ROAD N. E.  
 ST. PAUL, OREGON 97137  
 (503) 633-2666

Well test  
 MARI 2068  
 Knowlview Nursery


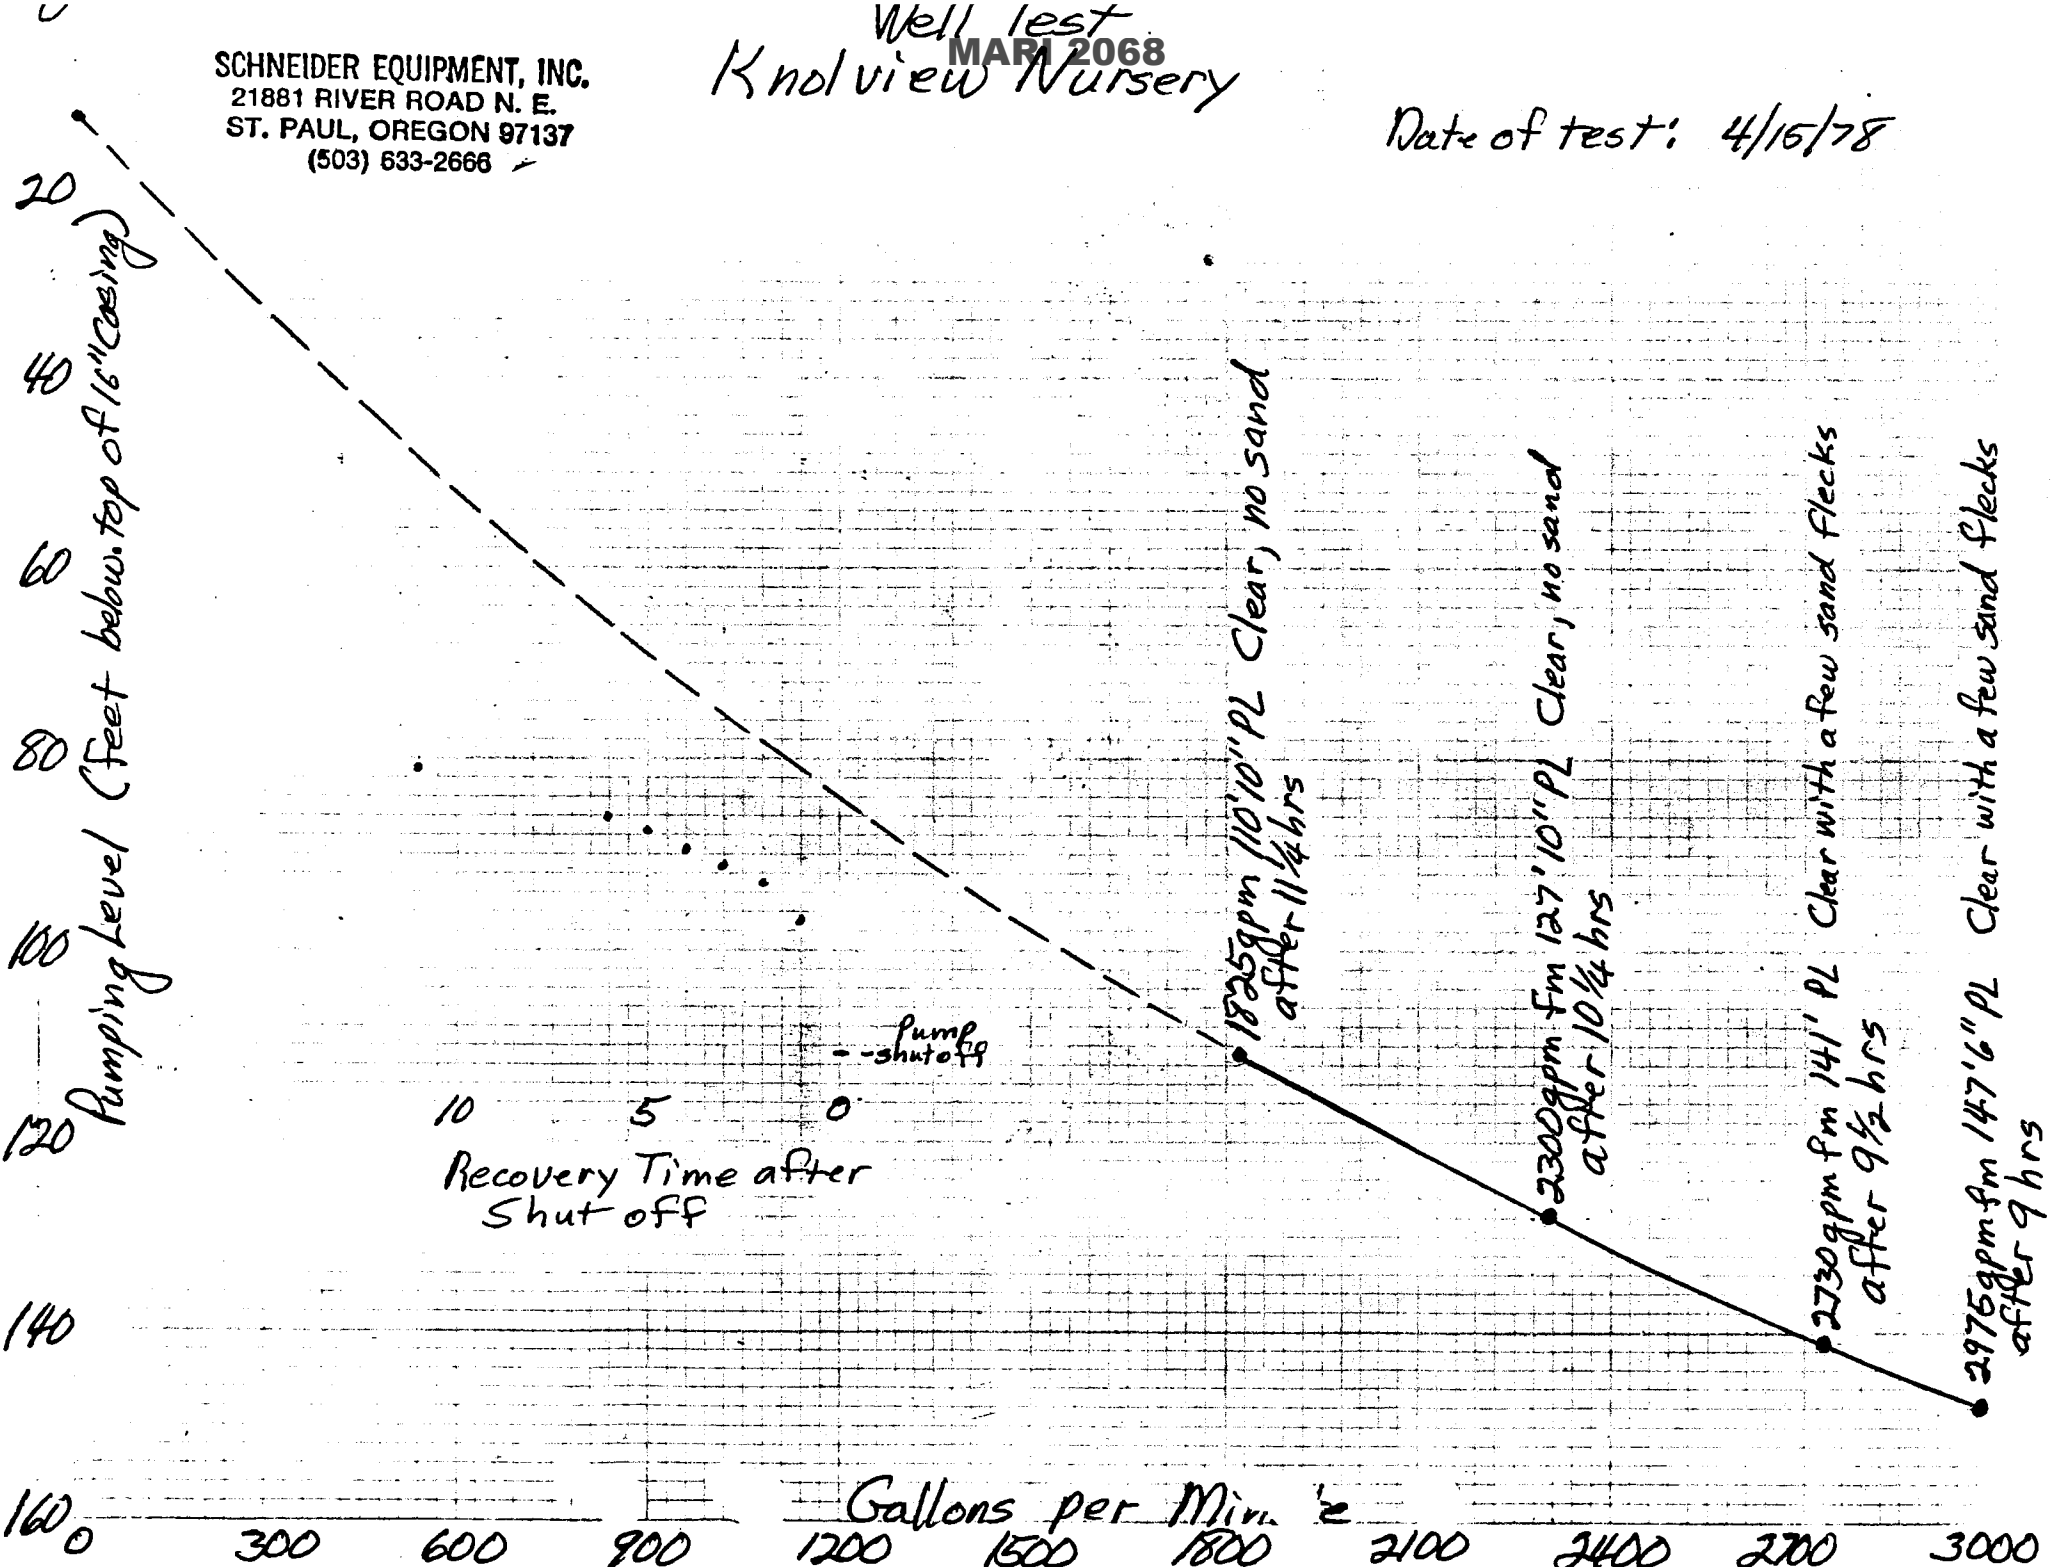



Oregon Water Resources Department
725 Summer Street NE, Suite A
Salem Oregon 97301
(503) 986-0900
www.oregon.gov/owrd

Application for Well ID Number

RECEIVED

Do not complete if the well already has a Well Identification Number.

FEB 25 2019

I. OWNER INFORMATION

OWRD

Current Owner Name (please print): Treco Investments LLC
Mailing Address: PO Box 98
City, State, Zip: Woodburn, OR 97071
Mail Well ID to: [X] SAME AS ABOVE [ ] In Care Of (C/O)
Name & Address:
City, State, Zip:

II. WELL LOCATION INFORMATION (Please fill out as completely as possible)

Township: 5S (North / South) Range: 1W (East / West) Section: 29 SE 1/4 of the SW 1/4
Tax Lot (usually last 3-5 numbers of Tax Map #): 1500 County Marion
GPS Coordinates: Lat. 45.10357 Long. -122.84028 N 45 Degrees 6'13.09565" W 122 Degrees 50'24.99079"
Street Address of Well, City: No site address - west of 10816 Monitor-McKee Rd NE, Woodburn, OR 97071
If the property had a different street address in the past:

III. GENERAL WELL INFORMATION (Please fill out as completely as possible, AND attach copy of Well Report, if available)

Use of Well (domestic, irrigation, commercial, industrial, monitoring): Irrigation
Date Well Constructed (or property built): 4-25-1978 Total Well Depth: 363 ft Casing Diameter: 16"
Owner at time the well was constructed (if known): Knolview Nursery Well Report # (if known): MARI 2068
Other Information:

SUBMITTED BY (please print): BRENT SMITH
PHONE: 503-634-2209 EMAIL &/or FAX: brent\_smith@treco.nu / 503-634-2344

Send application to: Oregon Water Resources Department 725 Summer St NE, Suite A, Salem, Oregon 97301; or fax to (503) 986-0902.
Applications are processed in the order they are received, and Well ID Numbers are mailed within 4-5 business days.

For Official Use Only by the Oregon Water Resources Department:
Received Date: 2-25-19 Well Report Number: MARI 2068 Well Identification #: L-133232