

MARI 20801

STATE ENGINEER
Salem, Oregon

MARI
20801

Well Record

STATE WELL NO. 7/3W-31K(1)
COUNTY
APPLICATION NO.

OWNER: M. W. Brownell MAILING ADDRESS: Route 3

LOCATION OF WELL: Owner's No. CITY AND STATE: Salem


NW 1/4 SE 1/4 Sec. 31 T. 7 N. S. R. 3 W., W.M.

Bearing and distance from section or subdivision corner

Altitude at well

TYPE OF WELL: Drilled Date Constructed 1959

Depth drilled 35 1/2 Depth cased

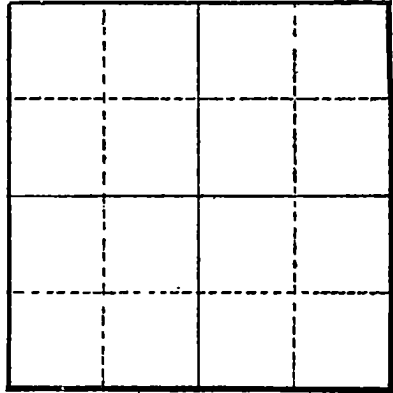

Section

CASING RECORD:

6-inch

FINISH:

AQUIFERS:

WATER LEVEL:

15.23 feet below top of casing which is of land surface

PUMPING EQUIPMENT: Type Jet H.P. Capacity G.P.M.

WELL TESTS:

Drawdown ft. after hours G.P.M. Drawdown ft. after hours G.P.M.

USE OF WATER Domestic Temp. °F., 19

SOURCE OF INFORMATION Owner observation

DRILLER or DIGGER Harry Robinson

ADDITIONAL DATA:

Log Water Level Measurements Chemical Analysis Aquifer Test

REMARKS:

Silt	0	6
Sand and clay	6	13.5
Loose sand and gravel	13.5	15.5
Sand, gravel and clay	15.5	29
Loose gravel	29	35.5