

STATE ENGINEER
Salem, Oregon

2/03
MAR 1960

Well Record

STATE WELL NO. 5/1W-30H
COUNTY Marion
APPLICATION NO. GR-1371

GR-1329

OWNER: Bernard N. Miller


MAILING ADDRESS: 378 Montgomery St.

LOCATION OF WELL: Owner's No. #1

CITY AND STATE: Woodburn, Oregon

SE 1/4 NE 1/4 Sec. 30 T. 5 S., R. 1 W., W.M.

Bearing and distance from section or subdivision corner 900' W. & 1800' S. from NE cor. Sec. 30.

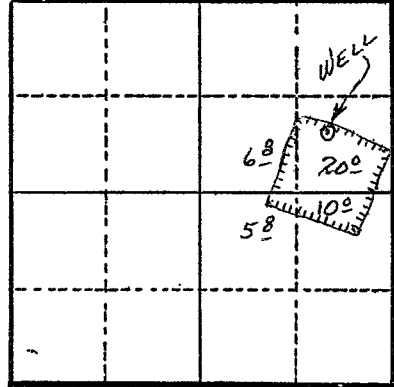

Section 30

Altitude at well 172

TYPE OF WELL: Drilled; Date Constructed 1948

Depth drilled 90 ft. Depth cased 90 ft.

CASING RECORD:

8 inch

FINISH:

AQUIFERS:

WATER LEVEL:

23 ft. ? 18.90 (2-2-60)

PUMPING EQUIPMENT: Type Turbine H.P. 10
Capacity 150 G.P.M.

WELL TESTS:

Drawdown 65 ft. after 125 hours G.P.M.
Drawdown ft. after hours G.P.M.

USE OF WATER Irrigation Temp. °F., 19

SOURCE OF INFORMATION G. R. Record

DRILLER or DIGGER Myron Ballweber

ADDITIONAL DATA:

Log N.A. Water Level Measurements Chemical Analysis Aquifer Test

REMARKS:

Irrigation of 44 acres.
Not used in 1960.