

STATE ENGINEER
Salem, Oregon

MARI. 2/27


Well Record

STATE WELL NO. 5/1W-31B
COUNTY Marion
APPLICATION NO. GR-3022

OWNER: Frank Nosack
MAILING ADDRESS: Route 1
CITY AND STATE: Gervais, Oregon

LOCATION OF WELL: Owner's No. #. #.
NW 1/4 NE 1/4 Sec. 31 T. 5 S., R. 1 W., W.M.

Bearing and distance from section or subdivision corner
450' S. and 680' E. from N 1/4 corner
Section 31

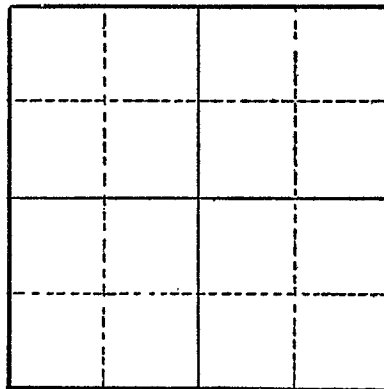

Section

Altitude at well

TYPE OF WELL: drilled Date Constructed 1951
Depth drilled 102 Depth cased 102

CASING RECORD:

6 inch

FINISH:

AQUIFERS:

Rock, gravels

WATER LEVEL:

30 feet

PUMPING EQUIPMENT: Type Meyers Jet H.P. 3/4
Capacity 50 G.P.M.

WELL TESTS:

Drawdown ft. after hours G.P.M.
Drawdown ft. after hours G.P.M.

USE OF WATER Irrigation Temp. °F. , 19

SOURCE OF INFORMATION GR-2829

DRILLER or DIGGER Irvin Sears

ADDITIONAL DATA:

Log Water Level Measurements Chemical Analysis Aquifer Test

REMARKS:

Rock, gravels