

STATE ENGINEER
Salem, Oregon

MARI... 2128

Well Record

STATE WELL NO. 5/LW-31B(1)
COUNTY Marion
APPLICATION NO.

OWNER: Frank Nosack


MAILING ADDRESS:

LOCATION OF WELL: Owner's No.

CITY AND STATE:

1/4 1/4 Sec. T. N. S, R. E. W., W.M.

Bearing and distance from section or subdivision corner

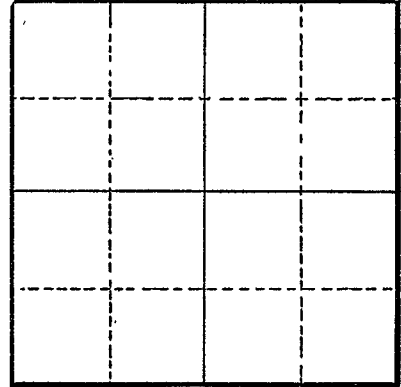

Section

Altitude at well 164

TYPE OF WELL: Drilled Date Constructed 1951

Depth drilled 102 Depth cased 102

CASING RECORD:

6 inch

FINISH:

AQUIFERS:

Gravel

WATER LEVEL:

30 feet below land surface on September 20, 1951

PUMPING EQUIPMENT: Type Jet H.P. 3/4
Capacity G.P.M.

WELL TESTS:

Drawdown ft. after hours G.P.M.
Drawdown ft. after hours G.P.M.

USE OF WATER Domestic, Irr.--5 acres Temp. °F., 19
SOURCE OF INFORMATION USGS

DRILLER or DIGGER

ADDITIONAL DATA:

Log Water Level Measurements Chemical Analysis Aquifer Test

REMARKS:

Domestic use only in 1960.