

STATE ENGINEER  
Salem, Oregon

MARI... 2/87

# Well Record


STATE WELL NO. 5/1W-35P(1)  
COUNTY Marion  
APPLICATION NO. GR-86

OWNER: Edward G. Zach  
MAILING ADDRESS:

LOCATION OF WELL: Owner's No. 1  
CITY AND STATE: Mt. Angel, Oregon

SE 1/4 SW 1/4 Sec. 35 T. 5 N. S. R. 1 W., W.M.

Bearing and distance from section or subdivision corner 500' N. of S 1/4 cor. Sec. 35, T. 5 S. R. 1 W.

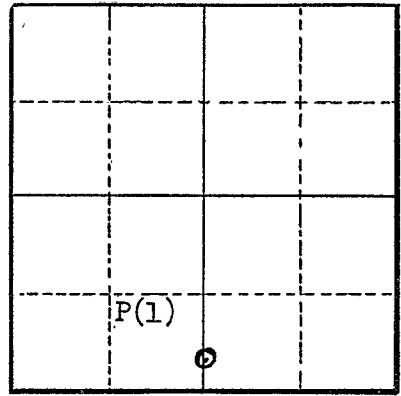

Altitude at well 169' Interpolated

TYPE OF WELL: Drilled Date Constructed 2/10/47

Depth drilled 160' Depth cased 160'

Section 35

### CASING RECORD:

8 inch casing set from 0 to 160 feet

### FINISH:

Miller knife 1 1/2" x 1/4" slots set from 65 to 75 feet

### AQUIFERS:

unknown

### WATER LEVEL:

18 feet below land surface 5/10/47

PUMPING EQUIPMENT: Type Turbine H.P. 5  
Capacity 100 G.P.M.

### WELL TESTS:

Drawdown 50 ft. after 100 hours G.P.M.  
Drawdown ft. after hours G.P.M.

USE OF WATER Irrigation 30 acres Temp. °F. 19

SOURCE OF INFORMATION Registration Statement GR-86

DRILLER or DIGGER Jim Ballweber Woodburn, Oregon

### ADDITIONAL DATA:

Log No. Water Level Measurements Chemical Analysis Aquifer Test

### REMARKS: