

STATE ENGINEER  
Salem, Oregon

2201 Well Record  
MAR... G-4016


STATE WELL NO. 5/1W-36r(1)  
COUNTY Marion  
APPLICATION NO. GR-236

OWNER: Robert M. & Cecelia A. Stuckart MAILING ADDRESS:

LOCATION OF WELL: Owner's No. 1 CITY AND STATE: Sublimity, Oregon

SE 1/4 SE 1/4 Sec. 36 T. 5 S., R. 1 W., W.M.

Bearing and distance from section or subdivision corner 12 chains N. & 22' W. of SE cor. Sec. 36

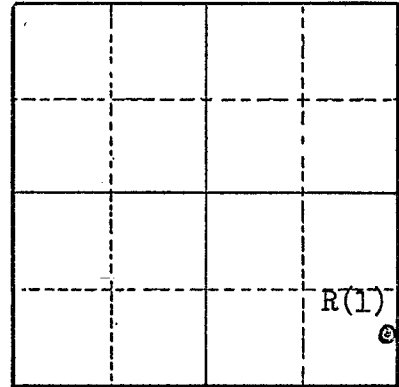

Section 36

Altitude at well 200' Interpolated

TYPE OF WELL: Drilled Date Constructed Oct. 53

Depth drilled 500' Depth cased 380'

CASING RECORD:

10 inch casing set from 0 to 380 feet  
10 inch rock hole from 380 to 500 feet

FINISH:

No record

AQUIFERS:

Rock from 373 to 500 feet

WATER LEVEL:

50 feet below land surface

PUMPING EQUIPMENT: Type Byron Jackson turbine H.P. 20  
Capacity 300 G.P.M.

WELL TESTS:

Drawdown 103 ft. after pumping 300 G.P.M.

Drawdown ft. after hours G.P.M.

USE OF WATER Irrigation 49 acres Temp. °F., 19

SOURCE OF INFORMATION Registration Statement GR-236

DRILLER or DIGGER

ADDITIONAL DATA:

Log Yes Water Level Measurements Chemical Analysis Aquifer Test

REMARKS:

