

STATE ENGINEER
Salem, Oregon

MAR 22 1950

Well Record

STATE WELL NO. 5/2W-1E
COUNTY Marion
APPLICATION NO. GR-924

OWNER: Edgar W. Crosby


MAILING ADDRESS: _____

LOCATION OF WELL: Owner's No. _____

CITY AND STATE: Woodburn

SW 1/4 NW 1/4 Sec. 1 T. 5 N. S., R. 2 W., W.M.

Bearing and distance from section or subdivision corner 550' E. & 300' N. from W¹ cor. Sec. 1

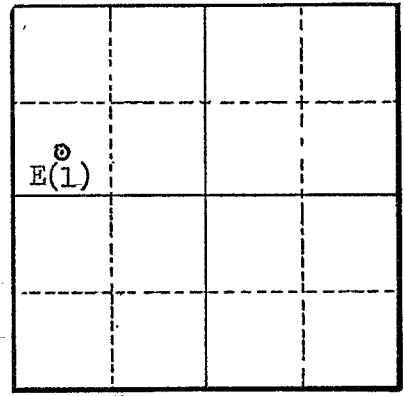

Section 1

Altitude at well 177

TYPE OF WELL: Drilled Date Constructed June 1950

Depth drilled 120 Depth cased 120

CASING RECORD:

10" steel 0 to 120'
16"

FINISH:

Cone strainer 10'x 6" dia. 70 to 80'
Pump set at 80' ?

AQUIFERS:

Sand

WATER LEVEL:

16'

PUMPING EQUIPMENT: Type Peerless turbine H.P. 30 Elec. GE
Capacity 600 G.P.M. pump set at 80 ?

WELL TESTS:

Drawdown 63 ft. after _____ hours 850 G.P.M.
Drawdown 55 ft. after _____ hours 600 G.P.M.

USE OF WATER Irrigation 10 1/2 acres Temp. _____ °F. _____, 19____

SOURCE OF INFORMATION Owner

DRILLER or DIGGER Vernon Coleman Woodburn, Oregon

ADDITIONAL DATA:
Log Water Level Measurements _____ Chemical Analysis _____ Aquifer Test _____

REMARKS:

Log sand