

STATE ENGINEER
Salem, Oregon

2211
M 171.....

Well Record

STATE WELL NO. 5/2W-1F(1)
COUNTY Marion
APPLICATION NO. GR-1012

GR-978

OWNER: Lloyd J. Waymire


MAILING ADDRESS: Rt. 1, Box 269

LOCATION OF WELL: Owner's No. #1

CITY AND STATE: Woodburn, Oregon

SE 1/4 NW 1/4 Sec. 1 T. 5 S., R. 2 W., W.M.

Bearing and distance from section or subdivision
corner 2350' E. & 1450' S. from NW cor. Sec. 1.

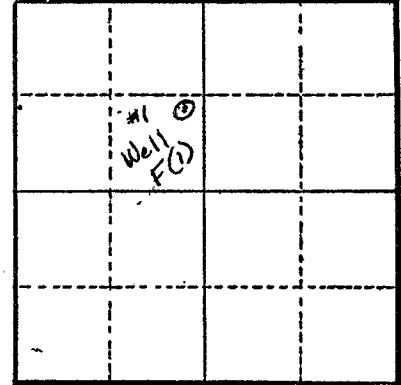

Section 1

Altitude at well 178

TYPE OF WELL: Drilled Date Constructed 1951

Depth drilled 129 ft. Depth cased 129 ft.

CASING RECORD:

8 inch

FINISH:

Perforated from 114 to 129.

AQUIFERS:

WATER LEVEL:

19 to 20 ft.

PUMPING EQUIPMENT: Type Pomona turbine H.P. 25

Capacity 450 G.P.M.

WELL TESTS:

Drawdown 35 ft. after 175 hours G.P.M.

Drawdown 50 ft. after 375 hours G.P.M.

USE OF WATER Irrigation Temp. °F., 19

SOURCE OF INFORMATION G.R. Record

DRILLER or DIGGER Fred Wymore

ADDITIONAL DATA:

Log Water Level Measurements Chemical Analysis Aquifer Test

REMARKS:

Log: Sand & clay-yellow	0 to 110 ft.
Gravel	110 to 116 ft.
Sand - black	116 to 129 ft.

Irrigation of 62 ft. @ cr. s.