

STATE ENGINEER  
Salem, Oregon

**Well Record**  
MAR 2 2015

STATE WELL NO. 5/2W-1P  
COUNTY Marion  
APPLICATION NO. GR-2660

OWNER: Roy G. Arney

MAILING ADDRESS: Route 1, Box 516

LOCATION OF WELL: Owner's No. #1

CITY AND STATE: Woodburn, Oregon

SE 1/4 SW 1/4 Sec. 1 T. 5 S., R. 2 W., W.M.

Bearing and distance from section or subdivision corner N. 700' & W. 651'


Section

Altitude at well

TYPE OF WELL: drilled Date Constructed 1947

Depth drilled 140 Depth cased

CASING RECORD:

FINISH:

AQUIFERS:

WATER LEVEL:

15 feet

PUMPING EQUIPMENT: Type Howard H.P. 1/2  
Capacity 50 G.P.M.

WELL TESTS:

Drawdown 10 ft. after hours pumping 100 G.P.M.  
Drawdown ft. after hours G.P.M.

USE OF WATER irrigation Temp. °F., 19

SOURCE OF INFORMATION GR-2522

DRILLER or DIGGER J. W. Beck, Canby, Oregon

ADDITIONAL DATA:

Log Water Level Measurements Chemical Analysis Aquifer Test

REMARKS:

MARI 2215

STATE ENGINEER  
Salem, Oregon

Well Record

STATE WELL NO. 5/2W-1P(1)  
COUNTY Marion  
APPLICATION NO.

OWNER: R. G. Arney


MAILING ADDRESS:

LOCATION OF WELL: Owner's No.

CITY AND STATE:

..... 1/4 ..... 1/4 Sec. .... T. .... N. E.  
S., R. .... W., W.M.

Bearing and distance from section or subdivision corner

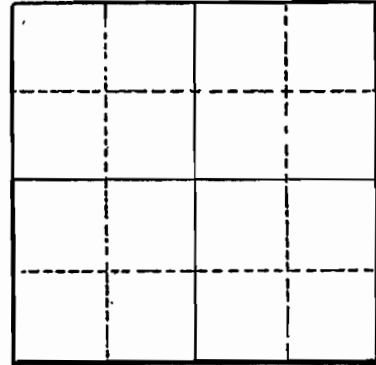

Section

Altitude at well 170

TYPE OF WELL: Drilled Date Constructed 1947

Depth drilled 140 Depth cased

CASING RECORD:

6 inch

FINISH:

AQUIFERS:

WATER LEVEL:

15 feet below land surface on January 15, 1947.

PUMPING EQUIPMENT: Type Jet H.P. 3  
Capacity G.P.M.

WELL TESTS:

Drawdown ft. after hours G.P.M.  
Drawdown ft. after hours G.P.M.

USE OF WATER Irrigation--32 acres Temp. °F., 19

SOURCE OF INFORMATION USGS

DRILLER or DIGGER

ADDITIONAL DATA:

Log Water Level Measurements Chemical Analysis Aquifer Test

REMARKS: