

STATE ENGINEER
Salem, Oregon

2225
MARI.....

Well Record

STATE WELL NO. 5/2W - 13 H(2)
COUNTY MARION
APPLICATION NO. GR-2108

OWNER: Isay Grigorieff


MAILING ADDRESS: Route 1, Box 255

LOCATION OF WELL: Owner's No.

CITY AND STATE: Woodburn, Oregon

NE ¼ SE ¼ Sec. 1 T. 5 N. S. R. 2 E. W.M.

Bearing and distance from section or subdivision corner

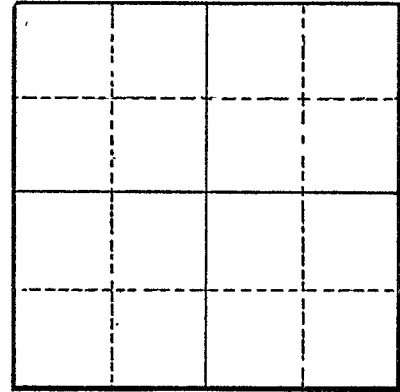

Section

Altitude at well

TYPE OF WELL: Drilled Date Constructed Before 1955

Depth drilled 96 Depth cased

CASING RECORD:

FINISH:

AQUIFERS:

WATER LEVEL:

20-feet

PUMPING EQUIPMENT: Type Jet pump H.P. 5
Capacity 60 G.P.M.

WELL TESTS:

Drawdown 20 ft. after hours Pumping 60 G.P.M.

Drawdown ft. after hours G.P.M.

USE OF WATER Irrigation Temp. °F., 19

SOURCE OF INFORMATION GR-2026

DRILLER or DIGGER

ADDITIONAL DATA:

Log Water Level Measurements Chemical Analysis Aquifer Test

REMARKS: