

STATE ENGINEER
Salem, Oregon

2280
121...
Well Record

STATE WELL NO. 5/2W-2B
COUNTY Marion
APPLICATION NO. GR-2881

Edward Wanner
OWNER: & / Mary Wanner


MAILING ADDRESS:

LOCATION OF WELL: Owner's No. # 1

CITY AND STATE: Woodburn, Oregon

NW 1/4 NE 1/4 Sec. 2 T. 5 S, R. 2 W., W.M.

Bearing and distance from section or subdivision corner
320 feet South and 2150 feet West from NE Corner,
Section 2.

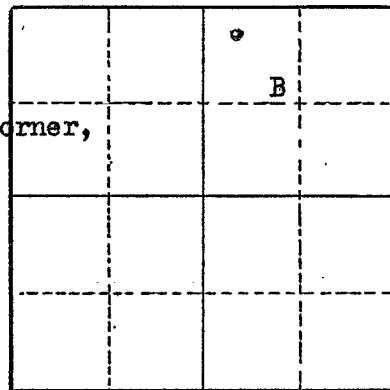

Section 2

Altitude at well

TYPE OF WELL: Drilled Date Constructed 1946

Depth drilled 141 feet Depth cased

CASING RECORD:

6-inch steel casing

FINISH:

AQUIFERS:

WATER LEVEL:

37 feet

PUMPING EQUIPMENT: Type Small Jet System to be replaced by H.P.
Capacity 150 G.P.M. irrigation system

WELL TESTS:

Drawdown ft. after hours G.P.M.
Drawdown ft. after hours G.P.M.

USE OF WATER Irrigation Temp. °F., 19

SOURCE OF INFORMATION GR-4100

DRILLER or DIGGER

ADDITIONAL DATA:

Log (NA) Water Level Measurements Chemical Analysis Aquifer Test

REMARKS: