

STATE ENGINEER
Salem, Oregon

2287
MARI.

Well Record

GR- 1164


STATE WELL NO. 5/2W-2B(1)
COUNTY Marion
APPLICATION NO. GR- 1204

OWNER: Alfred Schiedler MAILING ADDRESS: Rt. 1, Box 291

LOCATION OF WELL: Owner's No. CITY AND STATE: Woodburn, Oregon

NW ¼ NE ¼ Sec. 2 T. 5 S., R. 2 W., W.M.

Bearing and distance from section or subdivision corner 1010' S. & 260' E. of N¼ cor. Sec. 2.

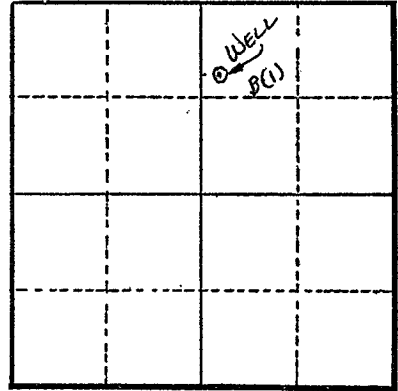

Section 2

Altitude at well 178 ft.

TYPE OF WELL: Drilled Date Constructed 1951

Depth drilled 128 ft. Depth cased 128 ft.

CASING RECORD:

10 inch

FINISH:

Perforated - unknown size from 112 to 120 ft.

AQUIFERS:

WATER LEVEL:

21 ft.

PUMPING EQUIPMENT: Type Berkeley turbone 4 in. H.P. 7½
Capacity 150 G.P.M.

WELL TESTS:	65	265	
Drawdown 53 ft. after	hours	200	G.P.M.
Drawdown 46 ft. after	hours	150	G.P.M.
Drawdown 40		100	

USE OF WATER Irrigation Temp. °F., 19

SOURCE OF INFORMATION G. R. Record

DRILLER or DIGGER Stierman Bros.

ADDITIONAL DATA:

Log Water Level Measurements Chemical Analysis Aquifer Test

REMARKS:

Log: Unknown	0 to 107 ft.
Sand & gravel	107 to 120 ft.
Sand	120 to 128 ft.

Irrigation of 55 acres.