

STATE ENGINEER
Salem, Oregon

MARION Well Record

STATE WELL NO. 5/2W-2J(1)
COUNTY Marion
APPLICATION NO. GR-703

OWNER: Laurence Meininger


MAILING ADDRESS: Route 1, Box 266

LOCATION OF WELL: Owner's No. #1

CITY AND STATE: Woodburn, Oregon

NE 1/4 SE 1/4 Sec. 2 T. 5 S., R. 2 W., W.M.

Bearing and distance from section or subdivision corner 155 feet N. & 260 feet W. of most N'ly N.W. corner of Moses Lore D. L. C.

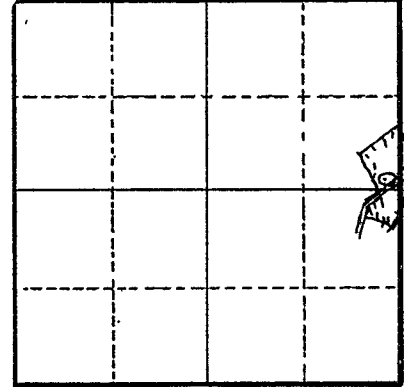

Altitude at well 172 feet interpolated

TYPE OF WELL: Drilled Date Constructed Sept. 10, 1950

Depth drilled 247 Depth cased 247

Section

CASING RECORD:

8 inch

FINISH:

AQUIFERS:

WATER LEVEL:

19 feet below land surface on September 15, 1950

PUMPING EQUIPMENT: Type Turbine H.P. 10
Capacity 120 G.P.M.

WELL TESTS:

Drawdown 45 ft. after hours G.P.M.
Drawdown ft. after hours G.P.M.

USE OF WATER Irrigation 19 acres Temp. °F., 19

SOURCE OF INFORMATION USGS GR-703

DRILLER or DIGGER

ADDITIONAL DATA:

Log Water Level Measurements Chemical Analysis Aquifer Test

REMARKS: