

STATE ENGINEER
Salem, Oregon

2290
MARI.....

Well Record


STATE WELL NO. 5/2W-2M
COUNTY Marion
APPLICATION NO. GR-3370

OWNER: Vassili Konovalov MAILING ADDRESS: Route 1,

LOCATION OF WELL: Owner's No. _____ CITY AND STATE: Woodburn, Oregon

NW $\frac{1}{4}$ SW $\frac{1}{4}$ Sec. 2 T. 5 N. S., R. 2 E. W., W.M.

Bearing and distance from section or subdivision corner 1150' S. and 90' E.

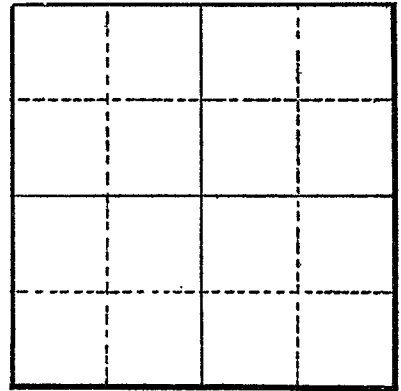

Section _____

Altitude at well _____

TYPE OF WELL: drilled Date Constructed 1953

Depth drilled 160' Depth cased 160'

CASING RECORD:

8"

FINISH:

perferated 10 perforations per foot 1 x 1/4 from 90 to 160'

AQUIFERS:

WATER LEVEL:

20'

PUMPING EQUIPMENT: Type Jet H.P. 5
Capacity 160 G.P.M.

WELL TESTS:

Drawdown 40 ft. after _____ hours pumping 180 G.P.M.
Drawdown _____ ft. after _____ hours _____ G.P.M.

USE OF WATER Irrigation Temp. _____ °F. _____, 19_____

SOURCE OF INFORMATION GR-3117

DRILLER or DIGGER Edmond Denskey, Route 1, Woodburn, Oregon

ADDITIONAL DATA:

Log _____ Water Level Measurements _____ Chemical Analysis _____ Aquifer Test _____

REMARKS: