

2292
M 191

Well Record

OWNER: Dennis Woelke MAILING ADDRESS:

LOCATION OF WELL: Owner's No. CITY AND STATE:


1/4 1/4 Sec. T. N. E. S., R. W., W.M.

Bearing and distance from section or subdivision corner

Altitude at well 178

TYPE OF WELL: Drilled Date Constructed 1953

Depth drilled 97 Depth cased 96

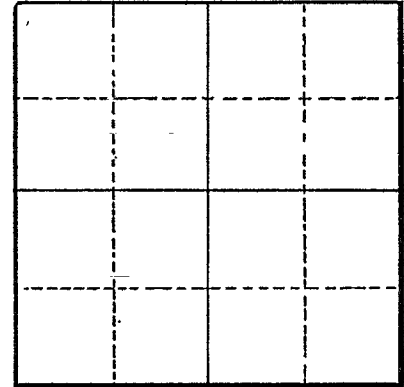

Section

CASING RECORD:

6 inch

FINISH:

Casing perforated 81 to 96
Gravel packed

AQUIFERS:

Black sand from 81 to 96'

WATER LEVEL:

22 feet below land surface on September 29, 1953

PUMPING EQUIPMENT: Type Turbine H.P. 3
Capacity G.P.M.

WELL TESTS:

Drawdown ft. after hours G.P.M.
Drawdown ft. after hours G.P.M.

USE OF WATER Irrigation--7 acres Temp. °F. 19

SOURCE OF INFORMATION USGS

DRILLER or DIGGER

ADDITIONAL DATA:

Log Water Level Measurements Chemical Analysis Aquifer Test

REMARKS: