

STATE ENGINEER
Salem, Oregon

MARI 23/10

Well Record


STATE WELL NO. 5/2W-3H(1)
COUNTY Marion
APPLICATION NO. CR242

OWNER: Anna Danskey MAILING ADDRESS:

LOCATION OF WELL: Owner's No. CITY AND STATE:

1/4 1/4 Sec. T. N. S., R. E. W., W.M.

Bearing and distance from section or subdivision corner

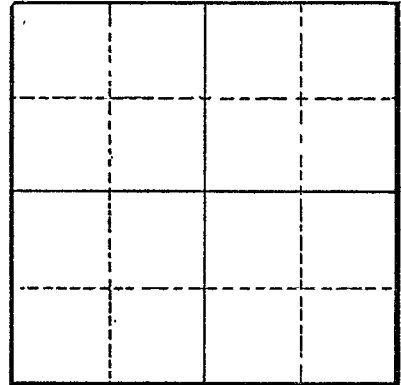

Section

Altitude at well 170

TYPE OF WELL: Drilled Date Constructed 1951

Depth drilled 112 Depth cased 106

CASING RECORD:

10 inch

FINISH:

Casing perforated 92 to 104

AQUIFERS:

Sand and gravel from 92 to 106

WATER LEVEL:

18 feet below land surface, September, 1952

PUMPING EQUIPMENT: Type Turbine H.P. 20
Capacity G.P.M.

WELL TESTS:

Drawdown ft. after hours G.P.M.
Drawdown ft. after hours G.P.M.

USE OF WATER Irrigation--38 acres Temp. °F. 19

SOURCE OF INFORMATION USGS

DRILLER or DIGGER

ADDITIONAL DATA:

Log Water Level Measurements Chemical Analysis Aquifer Test

REMARKS:

