

STATE ENGINEER
Salem, Oregon

332
MARI...
See deepening: MARI 2335

Well Record

STATE WELL NO. 5/2W-5N
COUNTY Marion
APPLICATION NO. GR-817

OWNER: Phillip E. Wolf


MAILING ADDRESS: Rt. 1

LOCATION OF WELL: Owner's No. _____

CITY AND STATE: Gervais

SW_{1/4} SW_{1/4} Sec. 5 T. 5 S., R. 2 W., W.M.

Bearing and distance from section or subdivision corner from NW cor. Sec. 8 E. 300' then N. 350'

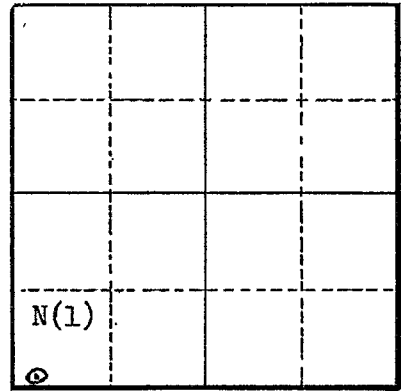

Section 5

Altitude at well 155

TYPE OF WELL: Drilled Date Constructed Nov. 1953

Depth drilled 130 Depth cased _____

CASING RECORD:

18" diameter 3/8" steel 0 to 130'

FINISH:

Mills knife perforations zig zag 352 1/4 x 3" 117 to 128 feet

AQUIFERS:

117 to 128 feet black sand, broken sand and gravel with clay streaks

WATER LEVEL:

18 feet

PUMPING EQUIPMENT: Type Meyers turbine H.P. 30
Capacity 400 G.P.M.

WELL TESTS:

Drawdown 77 ft. after _____ hours 350 G.P.M.
Drawdown _____ ft. after _____ hours _____ G.P.M.

USE OF WATER Irrigation Temp. _____ °F. _____, 19____

SOURCE OF INFORMATION Owner

DRILLER or DIGGER _____

ADDITIONAL DATA:

Log x Water Level Measurements _____ Chemical Analysis _____ Aquifer Test _____

REMARKS:

