

STATE ENGINEER
Salem, Oregon

Well Record

STATE WELL NO. 5/2W-8E
COUNTY MARION
APPLICATION NO. GR-4085


3346
MARI.....

OWNER: Ray C. Hagenauer MAILING ADDRESS: Rt 1 Box 12

LOCATION OF WELL: Owner's No. CITY AND STATE: Woodburn

SW 1/4 NW 1/4 Sec. 8 T. 5 S., R. 2 W., W.M.

Bearing and distance from section or subdivision corner s 41° 0' E 1910' from NW cor Sec 8 T5s R2W

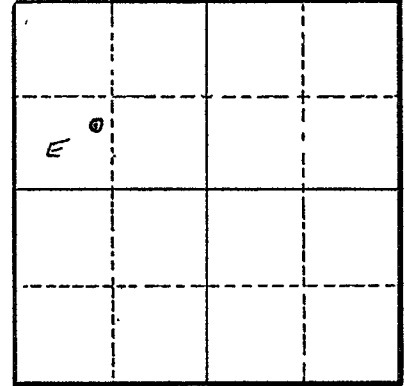

Section 8

Altitude at well _____

TYPE OF WELL: Drilled Date Constructed 1955

Depth drilled 135' Depth cased 135'

CASING RECORD:
6-inch

FINISH: 1/2" x 2" perforations 8 per row - rows 1' apart

AQUIFERS:

WATER LEVEL: 27'

PUMPING EQUIPMENT: Type Jet H.P. 3
Capacity _____ G.P.M.

WELL TESTS:
Drawdown 60 ft. after _____ hours 60 G.P.M.
Drawdown _____ ft. after _____ hours _____ G.P.M.

USE OF WATER Irrigation Temp. _____ °F., 19 _____

SOURCE OF INFORMATION GR-3966

DRILLER or DIGGER _____

ADDITIONAL DATA:
Log NA Water Level Measurements _____ Chemical Analysis _____ Aquifer Test _____

REMARKS: