

STATE ENGINEER
Salem, Oregon

2347
MARION.....

Well Record


STATE WELL NO. 5/2W-8E(1)
COUNTY Marion
APPLICATION NO.

OWNER: R. C. Hagenouer MAILING ADDRESS:

LOCATION OF WELL: Owner's No. CITY AND STATE:

..... 1/4 Sec. T. N. E. S., R. W., W.M.

Bearing and distance from section or subdivision corner

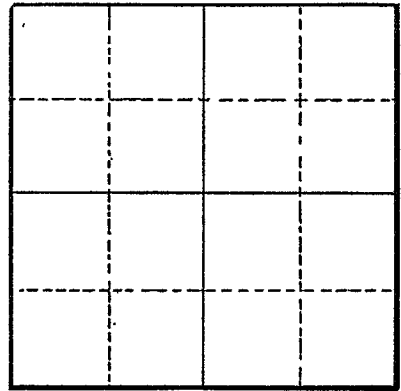

Altitude at well 162

TYPE OF WELL: Drilled Date Constructed 1955

Depth drilled 135 Depth cased 135

Section

CASING RECORD:
6 inch

FINISH:
Casing perforated 125 to 135

AQUIFERS:

WATER LEVEL:

PUMPING EQUIPMENT: Type Jet Capacity G.P.M. H.P. 1 1/2

WELL TESTS:
Drawdown ft. after hours G.P.M.
Drawdown ft. after hours G.P.M.

USE OF WATER Domestic, Irr.--13 acres Temp. °F. 19

SOURCE OF INFORMATION USGS

DRILLER or DIGGER

ADDITIONAL DATA:
Log Water Level Measurements Chemical Analysis Aquifer Test

REMARKS: