

STATE ENGINEER
Salem, Oregon

MARI... 2348


Well Record

STATE WELL NO. 5/2W-87(1)^F
COUNTY Marion
APPLICATION NO. GR-507
G-4005

OWNER: Robert Coleman MAILING ADDRESS: Route 1
LOCATION OF WELL: Owner's No. CITY AND STATE: Gervais, Oregon

SE 1/4 NW 1/4 Sec. 8 T. 5 N. S., R. 2 E. W., W.M.

Bearing and distance from section or subdivision corner

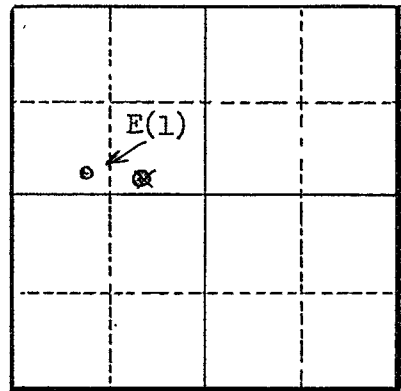

Water

Altitude at well 155' Interpolated

TYPE OF WELL: Drilled Date Constructed 1950

Depth drilled 86 Depth cased 74

Section 8

CASING RECORD:

18 inch set from 0 to 74 feet

FINISH:

open end casing, 2 1/2 yards of 1 1/4" gravel placed in well

AQUIFERS:

Coarse black sand and small gravel from 75 to 86 feet

WATER LEVEL:

12 feet below land surface

PUMPING EQUIPMENT: Type Turbine H.P. 40
Capacity _____ G.P.M.

WELL TESTS:

Drawdown 42 ft. after 72 hours pumping 1,000 G.P.M.
Drawdown 38 ft. after 30 hours pumping 800 G.P.M.

USE OF WATER Irrigation Temp. _____ °F., 19

SOURCE OF INFORMATION Well Driller and Mr. Coleman

DRILLER or DIGGER J. T. Miller

ADDITIONAL DATA:

Log Water Level Measurements _____ Chemical Analysis _____ Aquifer Test _____

REMARKS:

Well reported to flow in winter. Mr. Miller believes the well is capable of yielding 2,000 gpm.

See Registration Statement

