

STATE ENGINEER
Salem, Oregon

2403
MAR... Well Record

STATE WELL NO. 5/2W-11K(1)
COUNTY Marion
APPLICATION NO.

OWNER: Everette George MAILING ADDRESS:

LOCATION OF WELL: Owner's No. CITY AND STATE:


1/4 1/4 Sec. T. N. E. S., R. W., W.M.

Bearing and distance from section or subdivision corner

Altitude at well 172

TYPE OF WELL: Drilled Date Constructed 1955

Depth drilled 90 Depth cased 90

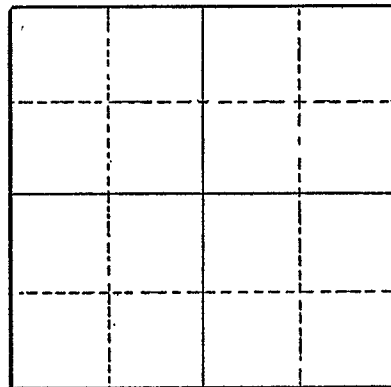

Section

CASING RECORD:

6 inch

FINISH:

Open bottom, casing unperforated

AQUIFERS:

WATER LEVEL:

20 feet below land surface on February 10, 1955

PUMPING EQUIPMENT: Type Jet H.P. 3 Capacity G.P.M.

WELL TESTS:

Drawdown ft. after hours G.P.M.

Drawdown ft. after hours G.P.M.

USE OF WATER Domestic, Irrigation-6 acres Temp. °F. 19

SOURCE OF INFORMATION USGS

DRILLER or DIGGER

ADDITIONAL DATA:

Log Water Level Measurements Chemical Analysis Aquifer Test

REMARKS: