

STATE ENGINEER
Salem, Oregon

2404
1171....

Well Record

STATE WELL NO. 5/2W-110
COUNTY Marion
APPLICATION NO. GR-3471

OWNER: R. A. Petzel


MAILING ADDRESS: Route 1, Box 318

LOCATION OF WELL: Owner's No.

CITY AND STATE: Gervais, Oregon

SW 1/4 SE 1/4 Sec. 11 T. 5 N. S., R. 2 E. W., W.M.

Bearing and distance from section or subdivision corner 470' N and 75' E.

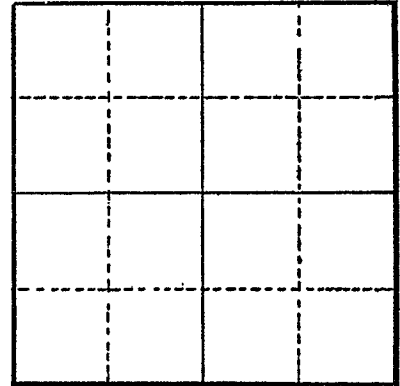

Section

Altitude at well

TYPE OF WELL: drilled Date Constructed 1954

Depth drilled 85' Depth cased 85'

CASING RECORD:

8"

FINISH:

AQUIFERS:

WATER LEVEL:

20'

PUMPING EQUIPMENT: Type Berkeley Turbine H.P. 10
Capacity 160 G.P.M.

WELL TESTS:

Drawdown ft. after hours pumping 300 G.P.M.
Drawdown 20 ft. after hours pumping 150 G.P.M.

USE OF WATER Irrigation Temp. °F., 19

SOURCE OF INFORMATION GR-3208

DRILLER or DIGGER Mr. Miller

ADDITIONAL DATA:

Log Water Level Measurements Chemical Analysis Aquifer Test

REMARKS: