


STATE ENGINEER
Salem, Oregon

2405 Well Record
MARI.....

STATE WELL NO. 5/2W-110
COUNTY Marion
APPLICATION NO. GR-3832

OWNER: Everett George MAILING ADDRESS: P.O. Box 44
CITY AND STATE: Woodburn, Oregon

LOCATION OF WELL: Owner's No. _____
SW 1/4 SE 1/4 Sec. 11 T. 5 N. S. R. 2 W., W.M.

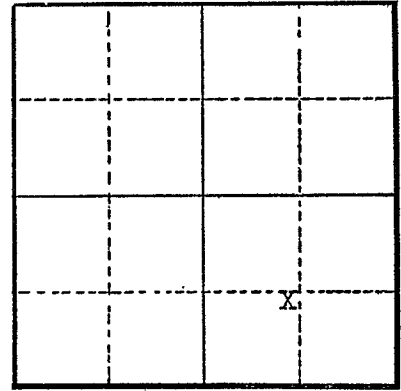

Section 11

Bearing and distance from section or subdivision corner Northerly along county road 1306' from SW Cor. J.E. Archibon DLC, thence westerly along county rd. 350', thence Southerly parallel with West line Lot 13 108'

Altitude at well _____

TYPE OF WELL: Drilled Date Constructed 2/3/55

Depth drilled 90 feet Depth cased 90 feet

CASING RECORD:

6 inch steel casing set to 90 feet

FINISH:

AQUIFERS:

WATER LEVEL:

20 feet below surface

PUMPING EQUIPMENT: Type Berkeley jet H.P. 3
Capacity 100 G.P.M.

WELL TESTS:

Drawdown 20 ft. after _____ hours 100 G.P.M.
Drawdown 40 ft. after _____ hours 300 G.P.M.

USE OF WATER Irrigation Temp. _____ °F., 19

SOURCE OF INFORMATION Well Registration Statement

DRILLER or DIGGER Willamette Drilling Company

ADDITIONAL DATA:

Log _____ Water Level Measurements _____ Chemical Analysis _____ Aquifer Test _____

REMARKS:

3493