

STATE ENGINEER
Salem, Oregon

OBSERVATION WELL

Well Record

STATE WELL NO. 4/1W-20(1) ^{C 2}
COUNTY Marion
APPLICATION NO. GR-782

OWNER: Will E. Dreher

MAILING ADDRESS: Rt. 2

LOCATION OF WELL: Owner's No. #1

CITY AND STATE: Aurora, Oregon

NW $\frac{1}{4}$ NW $\frac{1}{4}$ Sec. 2 T. 4 S., R. 1 W., W.M.


Bearing and distance from section or subdivision

corner #300' E. & 800' S. of NW corner of
section 2

Altitude at well 190 ft.

TYPE OF WELL: Drilled Date Constructed Oct. 10, '50

Depth drilled 134 ft. Depth cased _____

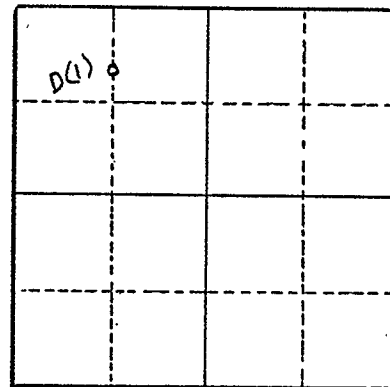

Section 2

CASING RECORD:

12 "

FINISH:

AQUIFERS:

WATER LEVEL:

PUMPING EQUIPMENT: Type Peerless pump H.P. 20
Capacity 450 G.P.M.

WELL TESTS:

Drawdown _____ ft. after _____ hours _____ G.P.M.

Drawdown _____ ft. after _____ hours _____ G.P.M.

USE OF WATER Irrigation - 40 acres Temp. _____ °F. _____, 19.

SOURCE OF INFORMATION GR-782

DRILLER or DIGGER John J. Miller, Sr.

ADDITIONAL DATA:

Log None Water Level Measurements ☒ Chemical Analysis _____ Aquifer Test _____

REMARKS: