

STATE ENGINEER
Salem, Oregon

2422
MARION
Well Record

STATE WELL NO. 5/2W - 12C
COUNTY MARION
APPLICATION NO. GR-2001

OWNER: Ray Stampley

MAILING ADDRESS: Rt. 1


LOCATION OF WELL: Owner's No. _____

CITY AND STATE: Woodburn, Oregon

NE $\frac{1}{4}$ NW $\frac{1}{4}$ Sec. 12 T. 5 N. S., R. 2 W. W.M.

Bearing and distance from section or subdivision

corner 2600' E. & 800' S.

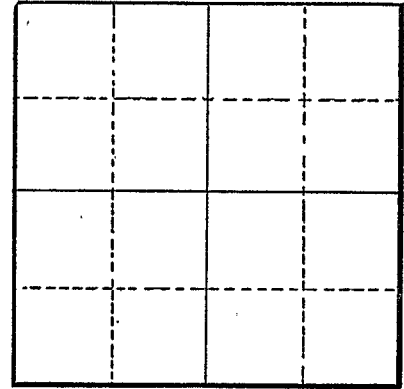

Section _____

Altitude at well 170

TYPE OF WELL: Drilled Date Constructed 1951

Depth drilled 143 Depth cased 143

CASING RECORD:

8-inch

FINISH:

Perforations from 123 to 143

AQUIFERS:

WATER LEVEL:

30-feet

PUMPING EQUIPMENT: Type Peerless Turbine H.P. 10
Capacity 200 G.P.M.

WELL TESTS:

Drawdown Sustained ft. after _____ hours Pumping 388 G.P.M.

Drawdown _____ ft. after _____ hours _____ G.P.M.

USE OF WATER Irrigation - 4 acres. Temp. _____ °F., 19 _____

SOURCE OF INFORMATION GR-1931

DRILLER or DIGGER John W. Beck, Canby, Oregon

ADDITIONAL DATA:

Log _____ Water Level Measurements _____ Chemical Analysis _____ Aquifer Test _____

REMARKS: