

STATE ENGINEER
Salem, Oregon

2433
MARI..... Well Record

STATE WELL NO. 5/2W-12P(1)
COUNTY Marion
APPLICATION NO. GR-53

OWNER: John H. Hooper


MAILING ADDRESS:

LOCATION OF WELL: Owner's No. 1

CITY AND STATE: Woodburn, Oregon

SE 1/4 SW 1/4 Sec. 12 T. 5 N. S., R. 2 W., W.M.

Bearing and distance from section or subdivision corner 600' N. & 900' W. of SE cor. of SW 1/4

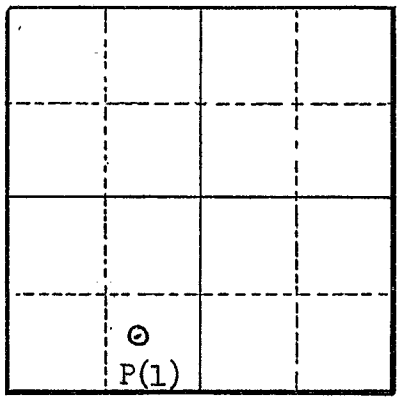

Section 12

Altitude at well 180' Interpolated

TYPE OF WELL: Drilled Date Constructed May 1950

Depth drilled 140' Depth cased 140'

CASING RECORD:

8 inch casing set from 0 to 140 feet

FINISH: Torch cut slits set at 28 to 30'
84 to 88'
109 to 111'
125 to 140'

AQUIFERS:

Sand from 28 to 30, 84 to 88, 109 to 111. Gravel from 125 to 140 feet

WATER LEVEL:

1t feet below land surface May 1950

PUMPING EQUIPMENT: Type Jacuzzi deep well turbine H.P. 15
Capacity 300 G.P.M.

WELL TESTS:

Drawdown 86 ft. after 550 hours G.P.M.
Drawdown ft. after hours G.P.M.

USE OF WATER Irrigation 60 acres Temp. °F., 19

SOURCE OF INFORMATION Registration Statement GR-53

DRILLER or DIGGER Coleman used rotary

ADDITIONAL DATA:

Log X Water Level Measurements Chemical Analysis Aquifer Test

REMARKS:

