

STATE ENGINEER
Salem, Oregon

Well Record

STATE WELL NO. 4/1W-2H(1)
COUNTY Marion
APPLICATION NO. GR-938

OWNER: William A. Jeskey

MAILING
ADDRESS:


LOCATION OF WELL: Owner's No.

CITY AND
STATE:

Aurora

SE $\frac{1}{4}$ NE $\frac{1}{4}$ Sec. 2 T. 4 N/ S, R. 1 W, W.M.

Bearing and distance from section or subdivision
corner 150 ft. N. & 100 ft. W. from the SE cor.
NE $\frac{1}{4}$

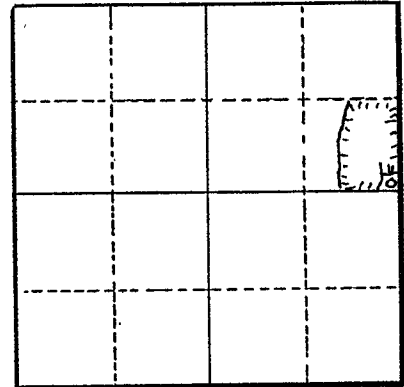

Section 2

Altitude at well 192

TYPE OF WELL: Drilled Date Constructed May, 1932

Depth drilled 126 Depth cased 126

CASING RECORD:

6 inch steel 0 ft to 126 ft.

FINISH:

AQUIFERS:

Sand & Gravel-117 ft to 126 ft.

WATER LEVEL:

74 ft.

PUMPING EQUIPMENT: Type Deming Mueller 5 $\frac{1}{2}$ " Turbine H.P. 5 Elec.
Capacity 60 G.P.M.

WELL TESTS:

Drawdown 16 ft. after hours 60 G.P.M.
Drawdown ft. after hours G.P.M.

USE OF WATER Irrigation--26 acres Temp. °F., 19
SOURCE OF INFORMATION Owner
DRILLER or DIGGER Pete Harnack

ADDITIONAL DATA:

Log X Water Level Measurements Chemical Analysis Aquifer Test

REMARKS:

State Well No. 4/1W-2H(1)
County Marion
Application No. _____

Owner: William A. Jeskey Owner's No. _____
Driller: Pete Harnack Date Drilled May, 1932

[illegible]