

STATE ENGINEER
Salem, Oregon

MARI. 2459

Well Record


STATE WELL NO. 5/2W-13H(1)
COUNTY Marion
APPLICATION NO. GR-189

OWNER: Kilian W. Smith
MAILING ADDRESS: 355 Settlemier Avenue

LOCATION OF WELL: Owner's No. 1
CITY AND STATE: Woodburn, Oregon

NE 1/4 NE 1/4 Sec. 13 T. 5 N. S. R. 2 E. W., W.M.

Bearing and distance from section or subdivision corner 540' N. & 120' W. from E 1/4 cor. of Sec. 13

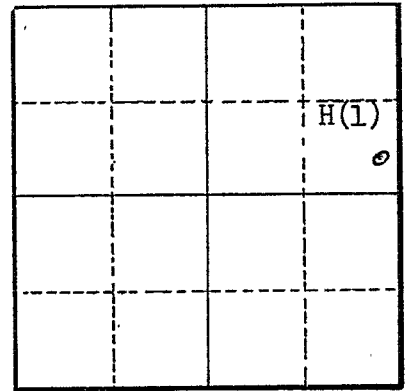

Section 13

Altitude at well 180' Interpolated

TYPE OF WELL: Drilled Date Constructed 4/4/55

Depth drilled 129 Depth cased 129

CASING RECORD:

8 inch casing set from 0 to 129 feet

FINISH:

10 perforations per foot (1/4" x 2") from 119 to 129 feet

AQUIFERS:

Sand and gravel from 32 to 129 feet

WATER LEVEL:

101 feet below land surface

PUMPING EQUIPMENT: Type Jacuzzi H.P. 5
Capacity 150 G.P.M.

WELL TESTS:

Drawdown _____ ft. after _____ hours _____ G.P.M.
Drawdown _____ ft. after _____ hours _____ G.P.M.

USE OF WATER Irrigation 6 acres Temp. _____ °F. _____, 19

SOURCE OF INFORMATION Registration Statement GR-189

DRILLER or DIGGER

ADDITIONAL DATA:

Log Yes Water Level Measurements _____ Chemical Analysis _____ Aquifer Test _____

REMARKS:

See permit 247 & 248

