

STATE ENGINEER  
Salem, Oregon

2466  
MAR 1947

# Well Record

STATE WELL NO. 5/2W-141(1)  
COUNTY Marion  
APPLICATION NO. GR-1065  
67219

GR-1027

OWNER: John Wiesz

MAILING ADDRESS:

LOCATION OF WELL: Owner's No.


CITY AND STATE:

Gervais, Oregon

NE 1/4 SW 1/4 Sec. 14 T. 5 S., R. 2 W., W.M.

Bearing and distance from section or subdivision

corner 2500' E. & 2200' N. from SW cor. Sec. 14.

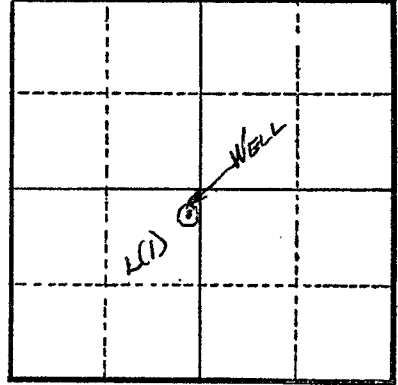

Section 14

Altitude at well 182 ft.

TYPE OF WELL: Drilled Date Constructed 1947

Depth drilled 137 ft. Depth cased 137 ft.

### CASING RECORD:

10 inch

### FINISH:

25 ft. of perforations ???

### AQUIFERS:

### WATER LEVEL:

22 ft.

PUMPING EQUIPMENT: Type F.M. Turbine

H.P. 20

Capacity 400 G.P.M.

### WELL TESTS:

Drawdown 45 ft. after 500 hours G.P.M.

Drawdown ft. after hours G.P.M.

USE OF WATER Irrigation

Temp. °F. 19

SOURCE OF INFORMATION G.R. Record

DRILLER or DIGGER H.A. Robinson

### ADDITIONAL DATA:

Log N.A. Water Level Measurements Chemical Analysis Aquifer Test

### REMARKS:

Irrigation of 61.8 acres.