

STATE ENGINEER
Salem, Oregon

2507
MAR 1953

Well Record

STATE WELL NO. 5/2W-17F(1)
COUNTY Marion
APPLICATION NO. GR-198

OWNER: J. Burford Brown


MAILING ADDRESS:

LOCATION OF WELL: Owner's No. #1

CITY AND STATE: Woodburn, Oregon

SE 1/4 NW 1/4 Sec. 17 T. 5 N. S. R. 2 W., W.M.

Bearing and distance from section or subdivision corner 955.5' W. and 558' N. from SE cor. Cornoyer DLC 49

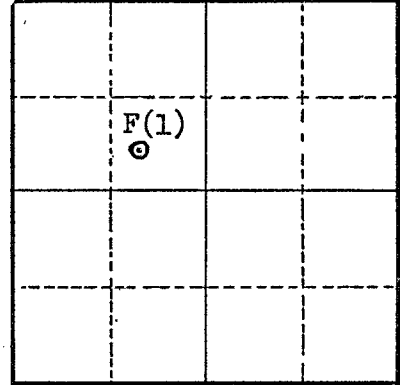

Section 17

Altitude at well 155' Interpolated

TYPE OF WELL: Drilled Date Constructed Jan '53

Depth drilled 150' Depth cased 150'

CASING RECORD:

12 inch casing set from 0 to 150 feet

FINISH:

299 perforations from 118 to 144 1/2 feet

AQUIFERS:

Sand and gravel 93 to 148 feet

WATER LEVEL:

8 feet below land surface Feb. 1953 15 feet below land surface 4/26/56

PUMPING EQUIPMENT: Type Jacuzzi H.P. 30
Capacity 600 G.P.M.

WELL TESTS:

Drawdown 40 ft. after pumping 425 hours G.P.M.
Drawdown 70 ft. after pumping 700 hours G.P.M.

USE OF WATER Irrigation 128 acres Temp. °F. 19

SOURCE OF INFORMATION Registration Statement GR-198

DRILLER or DIGGER

ADDITIONAL DATA:

Log Yes Water Level Measurements Chemical Analysis Aquifer Test

REMARKS:

