

STATE ENGINEER  
Salem, Oregon

MARI. 2513 Well Record

STATE WELL NO. 5/2W-17N  
COUNTY Marion  
APPLICATION NO. GR-1355

GR- 1310

OWNER: Brentford Miller Jr.


MAILING ADDRESS: Rt. 1, Box 420

LOCATION OF WELL: Owner's No.

CITY AND STATE: Woodburn, Oregon

SW 1/4 SW 1/4 Sec. 17 T. 5 S., R. 2 W., W.M.

Bearing and distance from section or subdivision corner 495' N. & 660' E. from SW cor. Sec. 17

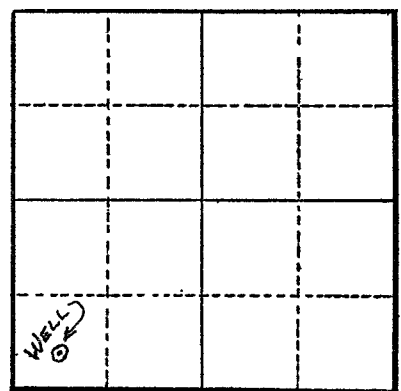

Section 17

Altitude at well 186 ft.

TYPE OF WELL: Drilled Date Constructed 1952

Depth drilled 61 ft. Depth cased 60 ft.

CASING RECORD:

12 inch

FINISH:

AQUIFERS:

WATER LEVEL:

13 ft. (10-24-52)

PUMPING EQUIPMENT: Type Jacuzzi 4 in. turbine H.P. 5  
Capacity 140 G.P.M.

WELL TESTS:

Drawdown 31 ft. after 190 hours G.P.M.  
Drawdown ft. after hours G.P.M.

USE OF WATER Irrigation Temp. °F. 19

SOURCE OF INFORMATION G. R. Record

DRILLER or DIGGER Perkins

ADDITIONAL DATA:

Log N.A. Water Level Measurements Chemical Analysis Aquifer Test

REMARKS:

Irrigation of 19.8 acres.