

STATE ENGINEER  
Salem, Oregon

MARI. 2514

# Well Record

STATE WELL NO. 5/2W-17P  
COUNTY Marion  
APPLICATION NO. GR-1291

GR-1248

OWNER: R. L. & Gladys M. Freeberg

MAILING

ADDRESS: 339 5th St.


LOCATION OF WELL: Owner's No. #1

CITY AND

STATE: Woodburn, Oregon

SE 1/4 SW 1/4 Sec. 17 T. 5 S., R. 2 W., W.M.

Bearing and distance from section or subdivision  
corner 350' W. & 500' N. from St. cor. Sec. 17

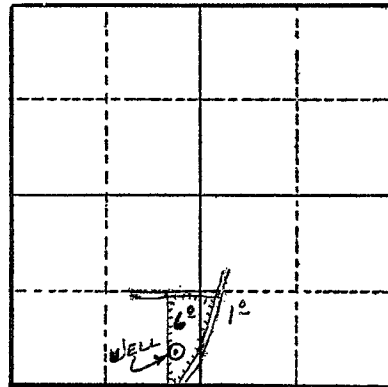

Section 17

Altitude at well 176 ft.

TYPE OF WELL: Drilled Date Constructed 1945

Depth drilled 107 ft. Depth cased 107 ft.

### CASING RECORD:

6 inch

### FINISH:

### AQUIFERS:

Quicksand from 70 to 90 ft.  
Water bearing gravel from 90 to 107 ft.

### WATER LEVEL:

18 ft. (Summer)

PUMPING EQUIPMENT: Type Jet

H.P. 1

Capacity 50 G.P.M.

### WELL TESTS:

Drawdown ft. after hours G.P.M.

Drawdown ft. after hours G.P.M.

USE OF WATER Irrigation Temp. °F., 19

SOURCE OF INFORMATION G. R. Record

DRILLER or DIGGER James Ballweber

### ADDITIONAL DATA:

Log N.A. Water Level Measurements Chemical Analysis Aquifer Test

### REMARKS:

Irrigation of 7 acres.