

STATE ENGINEER
Salem, Oregon

2535
MARION

Well Record

STATE WELL NO. 5/2W-19A(1)
COUNTY Marion
APPLICATION NO.

OWNER: Carl Neibler


MAILING ADDRESS:

LOCATION OF WELL: Owner's No.

CITY AND STATE:

1/4 1/4 Sec. T. N. E. S., R. W., W.M.

Bearing and distance from section or subdivision corner

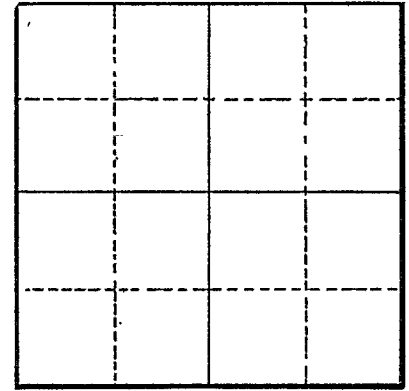

Altitude at well 150

Section

TYPE OF WELL: Drilled Date Constructed 1950

Depth drilled 95 Depth cased 95

CASING RECORD:

8 inch

FINISH:

Casing perforated 89 to 95

AQUIFERS:

Sand and gravel from 89 to 95

WATER LEVEL:

PUMPING EQUIPMENT: Type Centrifugal H.P. 10
Capacity G.P.M.

WELL TESTS:

Drawdown ft. after hours G.P.M.
Drawdown ft. after hours G.P.M.

USE OF WATER Irrigation--38 acres Temp. °F., 19

SOURCE OF INFORMATION USGS

DRILLER or DIGGER

ADDITIONAL DATA:

Log Water Level Measurements Chemical Analysis Aquifer Test

REMARKS:

Flows in winter.