


MARI 2538
Well Record

STATE ENGINEER
Salem, Oregon
MARI 2538

STATE WELL NO. ^{iw} 5/2~~W~~-19E
COUNTY Marion
APPLICATION NO. G-1244

OWNER: Cornelis Pieter Veldhuisen
MAILING ADDRESS: 1200 Belle Passi Rd.
CITY AND STATE: Woodburn, Oregon

LOCATION OF WELL: Owner's No. _____
SW 1/4 NW 1/4 Sec. 19 T. 5 S., R. 2 W., W.M.
Bearing and distance from section or subdivision
corner 5.5 ch. S. & 32 ch. E. from the NW
cor. of the J. Engle DLC #62.

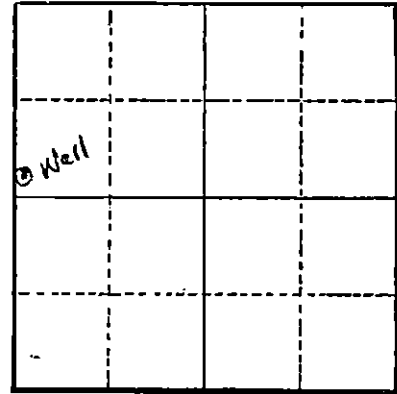

Section 19

Altitude at well 214 ft.

TYPE OF WELL: Drilled Date Constructed 1944
Depth drilled 130 ft. Depth cased 130 ft.

CASING RECORD:
10 inch

FINISH:

AQUIFERS:

WATER LEVEL:
100 ft.

PUMPING EQUIPMENT: Type Cook H.P. 5
Capacity 140 G.P.M.

WELL TESTS:
Drawdown _____ ft. after _____ hours _____ G.P.M.
Drawdown _____ ft. after _____ hours _____ G.P.M.

USE OF WATER Irrigation Temp. _____ °F., 19
SOURCE OF INFORMATION Belated registration statement

DRILLER or DIGGER _____
ADDITIONAL DATA:
Log _____ Water Level Measurements _____ Chemical Analysis _____ Aquifer Test _____

REMARKS:
Irrigation of 35 acres.



Oregon Water Resources Department
725 Summer Street NE, Suite A
Salem Oregon 97301
(503) 986-0900
www.oregon.gov/owrd

Application for
Well ID Number

RECEIVED

Do not complete if the well already has a Well Identification Number.

FEB 2 2022

OWRD

I. OWNER INFORMATION

Current Owner Name (please print): Fernandez Family Farm, LLC
Mailing Address: 13930 NE Boones Ferry Rd
City, State, Zip: Woodburn, OR 97071
Mail Well ID to: [X] SAME AS ABOVE [] In Care Of (C/O)
Name & Address:
City, State, Zip:

II. WELL LOCATION INFORMATION (Please fill out as completely as possible)

Township: 5 S (North / South) Range: 1 W (East / West) Section: 19 SW 1/4 of the NW 1/4
Tax Lot (usually last 3-5 numbers of Tax Map #): 1500 County Marion
GPS Coordinates: 45.123132, -122.863909
Street Address of Well, City: 1200 Belle Passi Rd NE Woodburn, OR 97071
If the property had a different street address in the past:

III. GENERAL WELL INFORMATION (Please fill out as completely as possible, AND attach copy of Well Report, if available)

Use of Well (domestic, irrigation, commercial, industrial, monitoring): Irrigation
Date Well Constructed (or property built): 1944 Total Well Depth: 130' Casing Diameter: 10"
Owner at time the well was constructed (if known): Cornelis Veldhuisen Well Report # (if known): MARI 2538
Other Information: Well record has incorrect range of 2 West. Correct range is 1 West, as entered above.
Water Right certificate 27220
SUBMITTED BY (please print): Maxwell J. Brentano, Principal RE Broker Brentano Realty, LLC
PHONE: (503) 537-8535 EMAIL &/or FAX: MaxBrentano@gmail.com

To send the completed application, you may MAIL it to: Oregon Water Resources Dept. 725 Summer St NE, Suite A, Salem, Oregon 97301.
Or EMAIL the completed PDF form to: Ladeena.K.Ashley@oregon.gov, or FAX it to: (503) 986-0902.

For Official Use Only by the Oregon Water Resources Department:

Received Date:
2-2-22

Well Report Number:
MARI 2538

Well Identification #:
L-145922