

STATE ENGINEER
Salem, Oregon

2541
M 121...

OBSERVATION WELL Well Record


STATE WELL NO. 5/2W-19Q(1)
COUNTY Marion
APPLICATION NO. GR-92

OWNER: Jess W. & Florence N. Lucas MAILING ADDRESS: _____

LOCATION OF WELL: Owner's No. _____ CITY AND STATE: Gervais, Oregon

SW 1/4 SE 1/4 Sec. 19 T. 5 N. S., R. 2 W., W.M.

Bearing and distance from section or subdivision corner 1900' W. & 500' N. from SE cor. Sec. 19

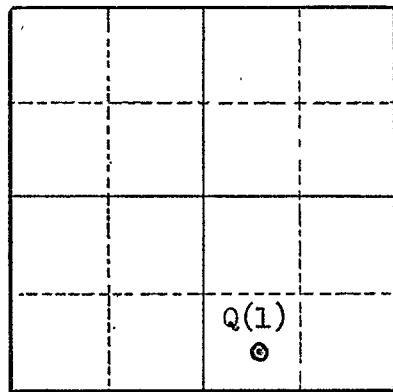

Section _____

Altitude at well 170

TYPE OF WELL: Drilled Date Constructed July 1951

Depth drilled 130 Depth cased 130

CASING RECORD:

10 inch set to 130 feet

FINISH:

Perforations from 100 to 130 feet

AQUIFERS:

Gravel from 100 to 130 feet

WATER LEVEL:

18 feet below land surface 23.10 (1-21-60)

PUMPING EQUIPMENT: Type Turbine H.P. 25
Capacity _____ G.P.M.

WELL TESTS:

Drawdown 125 ft. after _____ hours pumping _____ G.P.M.

Drawdown _____ ft. after _____ hours _____ G.P.M.

USE OF WATER Irrigation 114 acres Temp. _____ °F., 19

SOURCE OF INFORMATION GR-92

DRILLER or DIGGER _____

ADDITIONAL DATA:

Log Water Level Measurements _____ Chemical Analysis _____ Aquifer Test _____

REMARKS:

Water Level Record

OWNER: ? J.W. Lucas OWNER'S NO. _____

Description of measuring point: Top of casing on west side of well
0.1 feet above L.S.D.

Date	Water Level Feet (above) (below) Land Surface	Remarks	Date	Water Level Feet (above) (below) Land Surface	Remarks
5-30-57	20.34	WSB			
10-15-57	26.10	WSB			
6-11-58	21.30	WSB			
12-16-58	24.45	WSB			
5-6-59	20.32	WSB			
11-30-59	26.50	WSB			
6-6-60	22.06	WSB			
11-7-60	26.86	WSB			
3-30-61	20.29	WSB			
11-2-61	26.79	WSB RD			

REMARKS: Irrigation well