

STATE ENGINEER  
Salem, Oregon

4557  
MARION

# Well Record

STATE WELL NO. 5/2W-20A  
COUNTY Marion  
APPLICATION NO. GR-3540

OWNER: George T. Rush


MAILING ADDRESS: Route 1, Box 255

LOCATION OF WELL: Owner's No.

CITY AND STATE: Gervais, Oregon

NE 1/4 NE 1/4 Sec. 20 T. 5 N. S. R. 2 E. W., W.M.

Bearing and distance from section or subdivision corner 1/2 mile West of the St. Louis 4 Corners

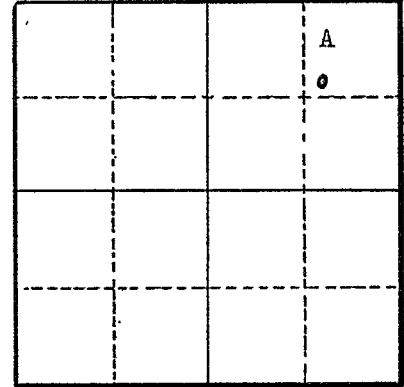

Section 20

Altitude at well

TYPE OF WELL: Drilled Date Constructed 1943

Depth drilled 60 feet Depth cased 60 feet

### CASING RECORD:

12-inch casing set from top to bottom of 60 feet

### FINISH:

### AQUIFERS:

### WATER LEVEL:

17 feet

PUMPING EQUIPMENT: Type Jacuzzi H.P.  
Capacity 87 G.P.M.

### WELL TESTS:

Drawdown ft. after hours G.P.M.

Drawdown ft. after hours G.P.M.

USE OF WATER Berry garden, home use, poultry, etc. Temp. °F., 19

SOURCE OF INFORMATION GR-4055

DRILLER or DIGGER Perkins

### ADDITIONAL DATA:

Log (NA) Water Level Measurements Chemical Analysis Aquifer Test

### REMARKS: